


# T.I.S.R.3 E. W.M.

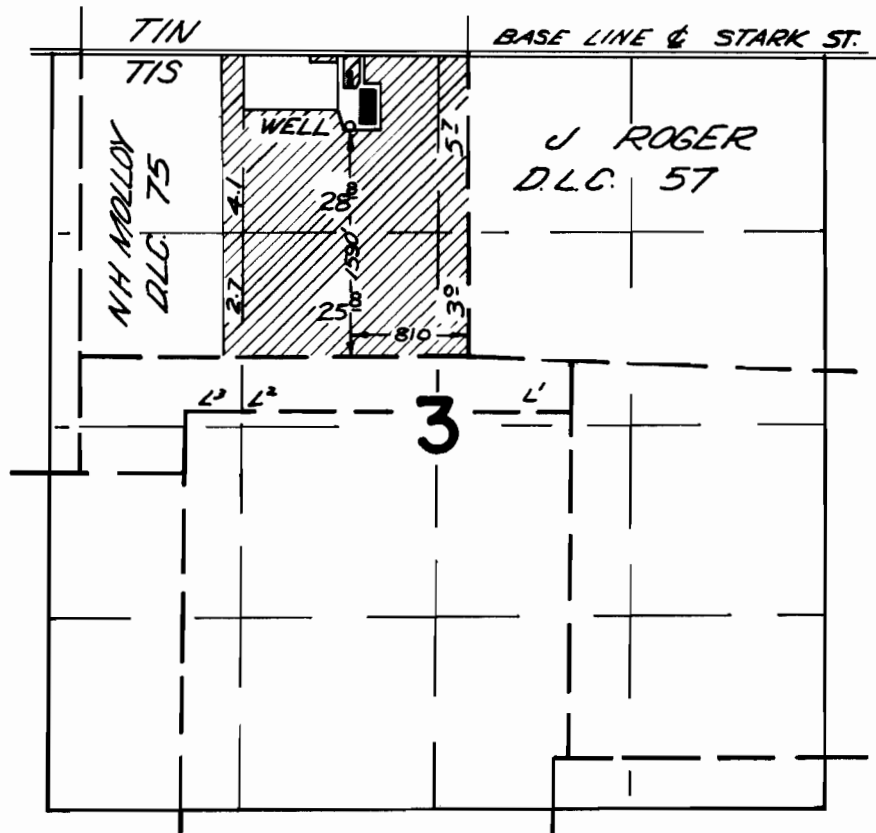

## FINAL PROOF SURVEY UNDER

Application No. G-2574 Permit No. G-2382  
IN NAME OF

J. FRANK SCHMIDT and SON CO.

Surveyed Aug. 31, 1966, by V. GARNER