


T.4 N. R.35 E. W.M.

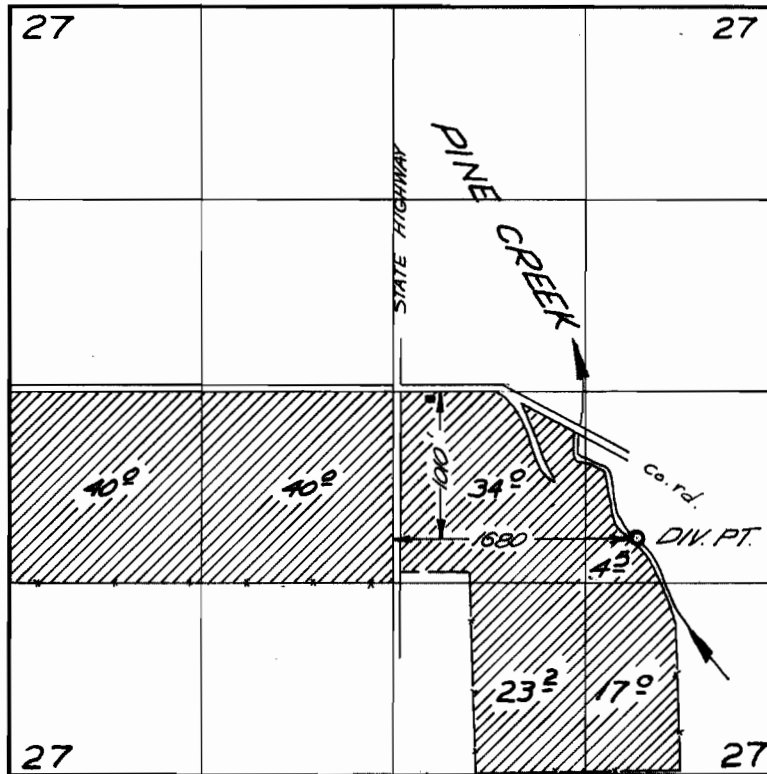

FINAL PROOF SURVEY
UNDER

Application No. 37953 Permit No. 28250
IN NAME OF

DALE ROBERT and ROBERT V. WOOD

Surveyed Oct. 31 1966, by V. GARNER