


T4N. R.35 E. W.M.

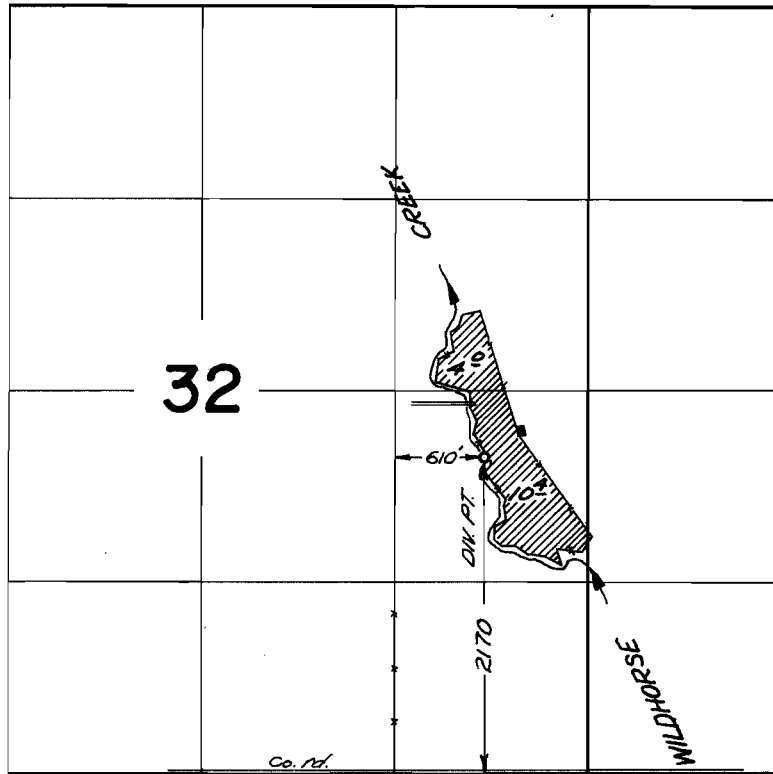

FINAL PROOF SURVEY UNDER

Application No. 40979 Permit No. 30558
IN NAME OF

WILLIAM R. and MIRIAM W. JOHNS

Surveyed Nov. 3, 1966 by V. GARNER