


T.1&2S.R.39E.W.M.

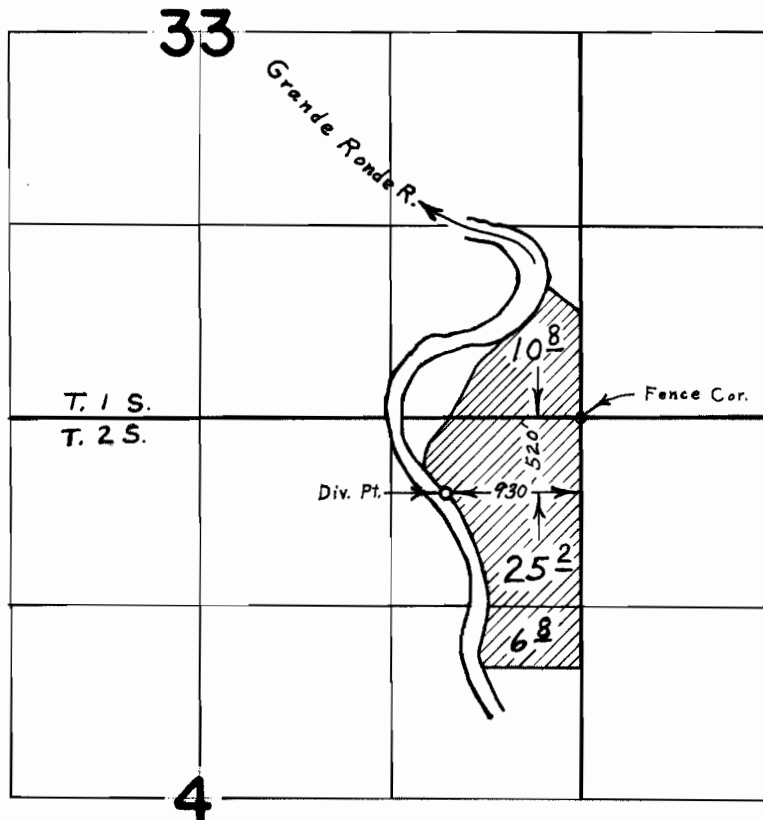

FINAL PROOF SURVEY
UNDER

Application No. 37436 Permit No. 27874
IN NAME OF

Marcel Tromp van Holst

Surveyed Nov. 3 1966, by L. E. Gould