


T.1S. R.2W.W.M.

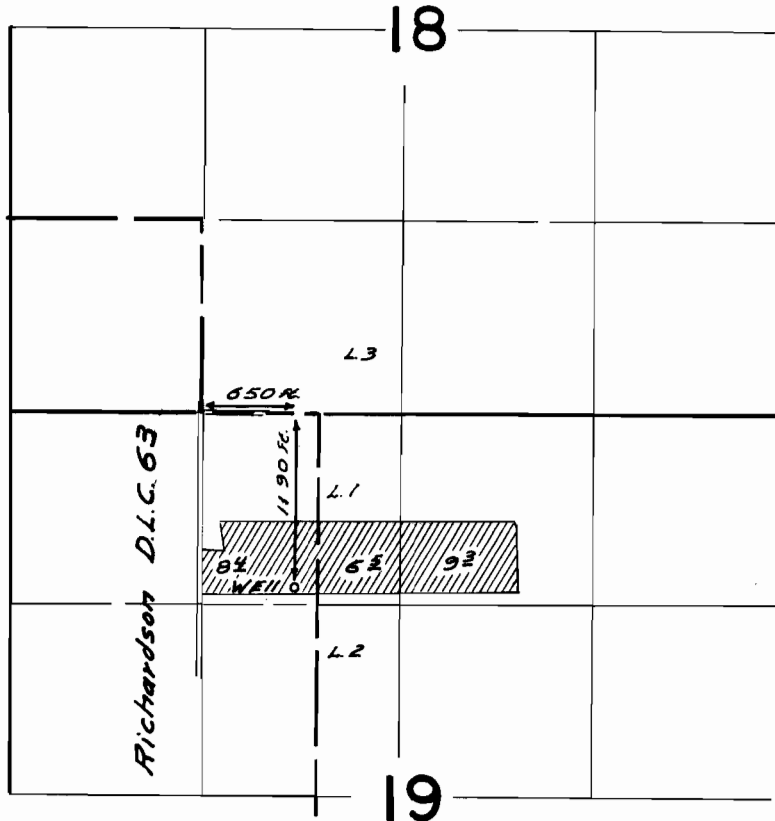

**FINAL PROOF SURVEY**  
UNDER

Application No. G-2483 Permit No. G-2293  
IN NAME OF

Fred Barby

Surveyed Aug 25 1966, by W. J. Ruppert