


T.3S.R.3W.W.M.

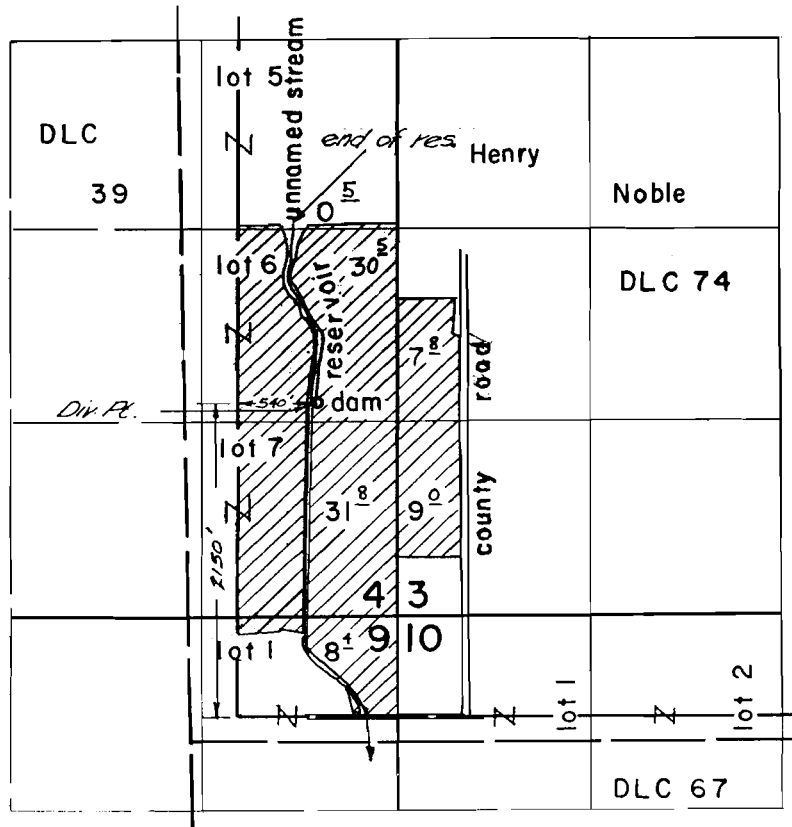

Note: DLC 74 changed to legal subdivision.

FINAL PROOF SURVEY UNDER

R-34377 R-2514
Application No. 34378 Permit No. 27016
IN NAME OF

Harold Lundquist

Surveyed Sept. 24 1964, by R. Jackson
Insp. Sept. 27, 1966 by V. Garner