T. 4 S. R. 4 W. W.M.

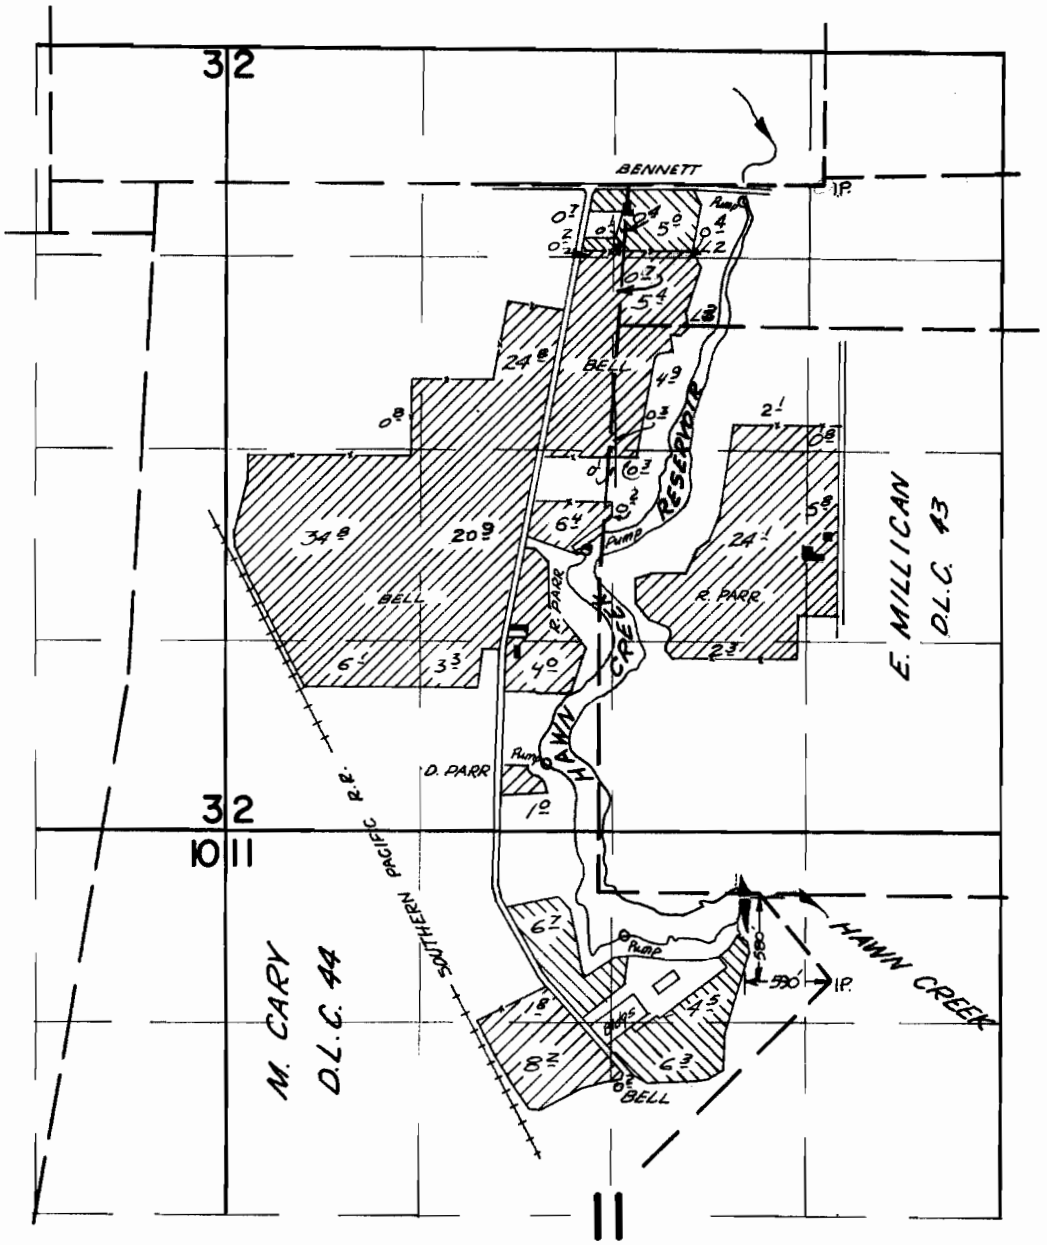

FINAL PROOF SURVEY

UNDER

Supp. Primary

R 34388 R 2570

Application No. 34389 Permit No. 27097

IN NAME OF

HAWN CREEK DIST. IMPROVEMENT CO.

Surveyed April 12, 1967, by V. GARNER

1967-B