


# T. 4 S. R. 4 W. W.M.

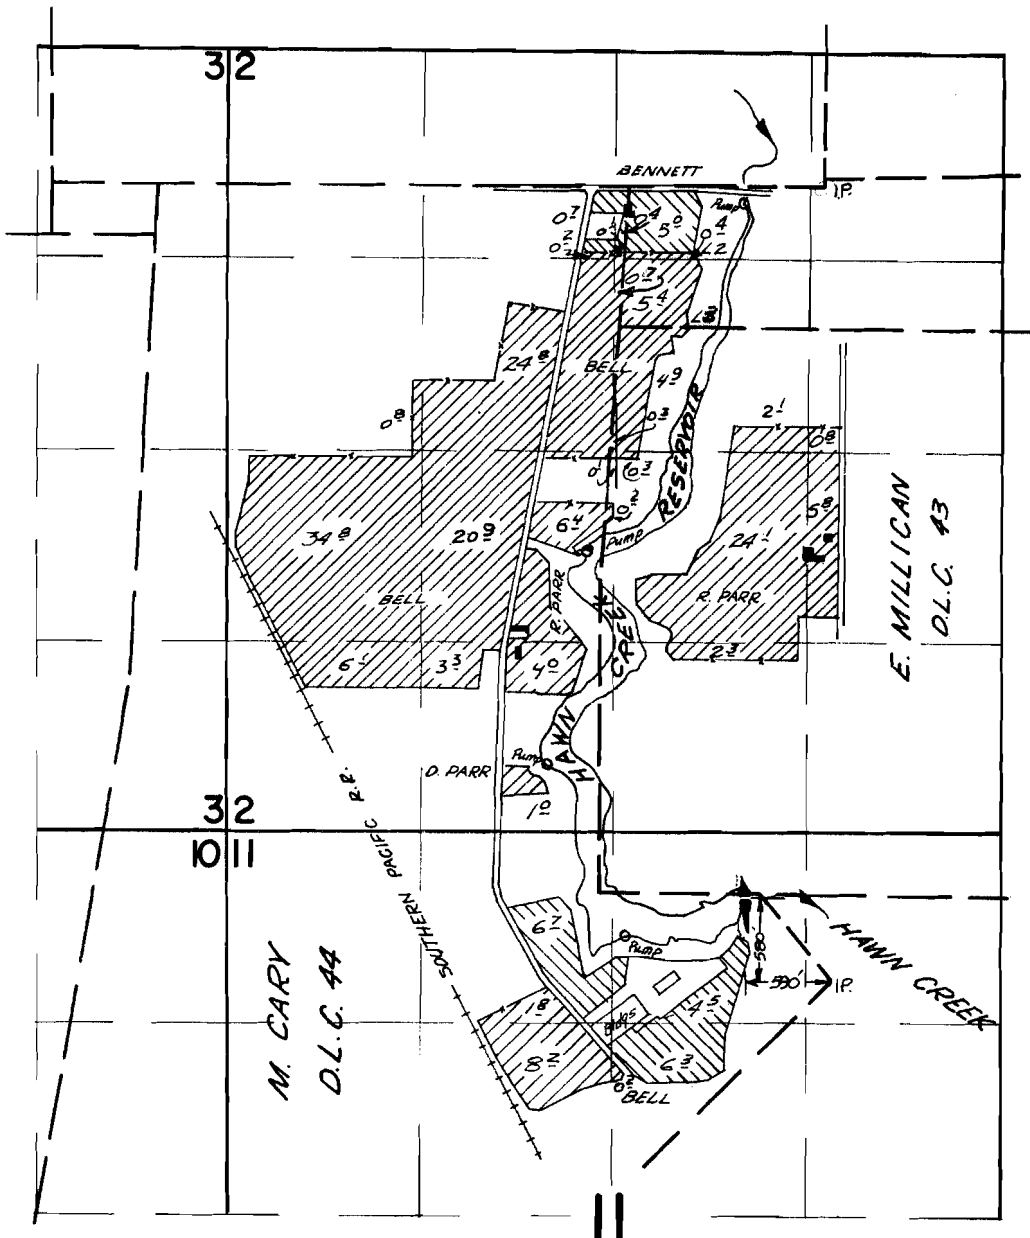

## FINAL PROOF SURVEY UNDER

*Supp.*
 *Primary*

R 34388                      R 2570  
 Application No. 34389    Permit No. 27097  
 IN NAME OF

*HAWK CREEK DIST. IMPROVEMENT CO.*

Surveyed *April 12, 1967*, by *V. GARNER*