


T.7S. R.39E. W.M.

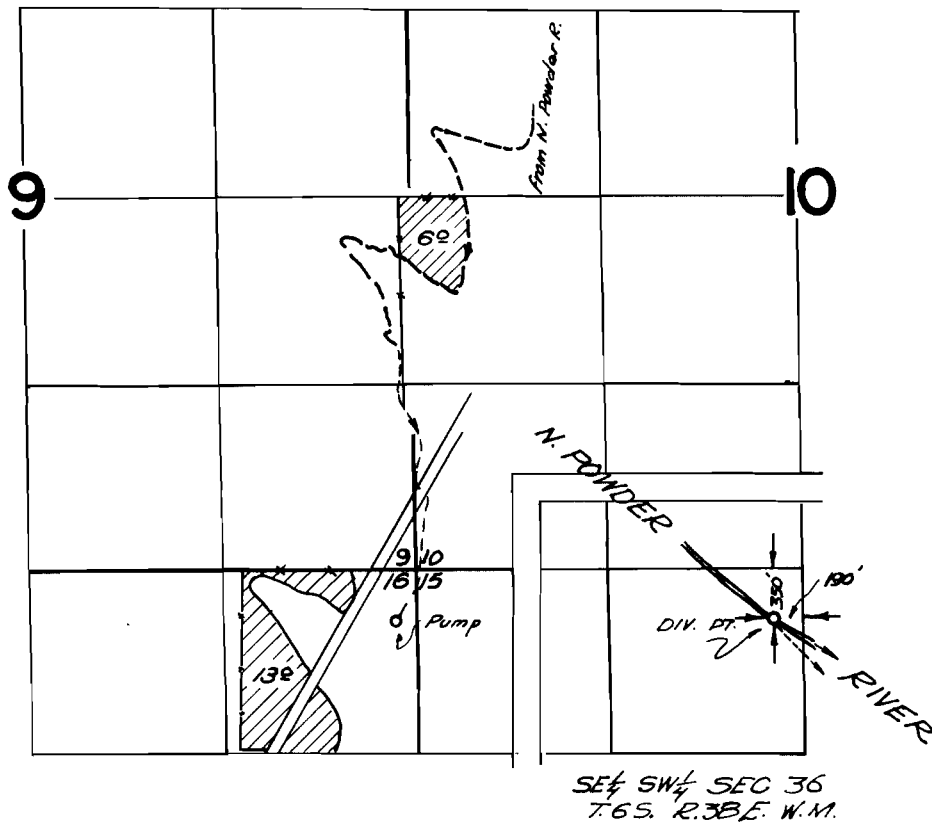

FINAL PROOF SURVEY UNDER

Application No. 40768 Permit No. 30385
IN NAME OF

MARION INMAN

Surveyed July 29, 1967, by V. Garner