


# T. 7S. R39 E. W.M.

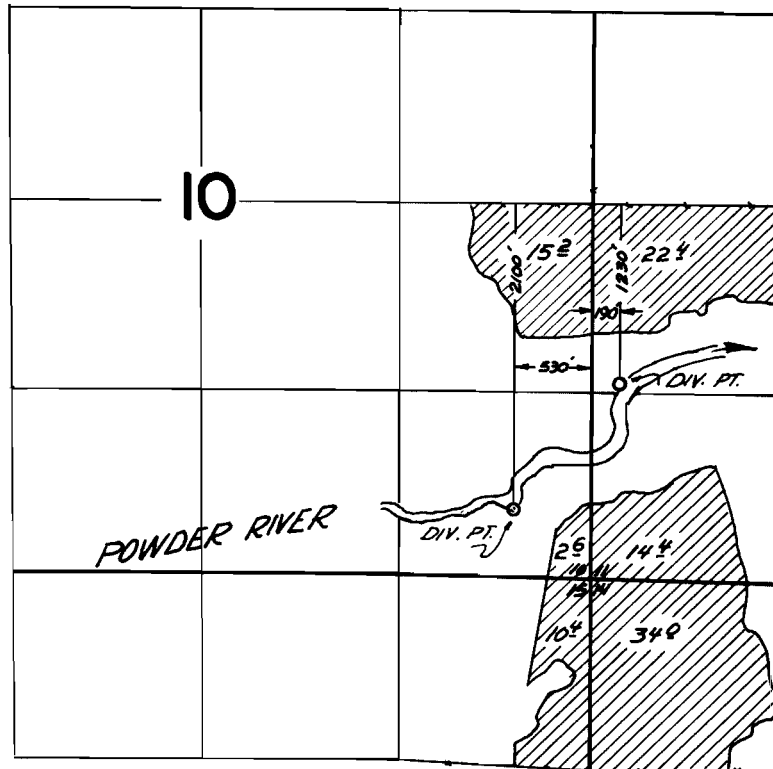

## FINAL PROOF SURVEY UNDER

Application No. 40769 Permit No. 30386  
IN NAME OF

MARION INMAN

Surveyed July 29 1967, by V. Garner