


T.10 S. R. 6 W. W.M.

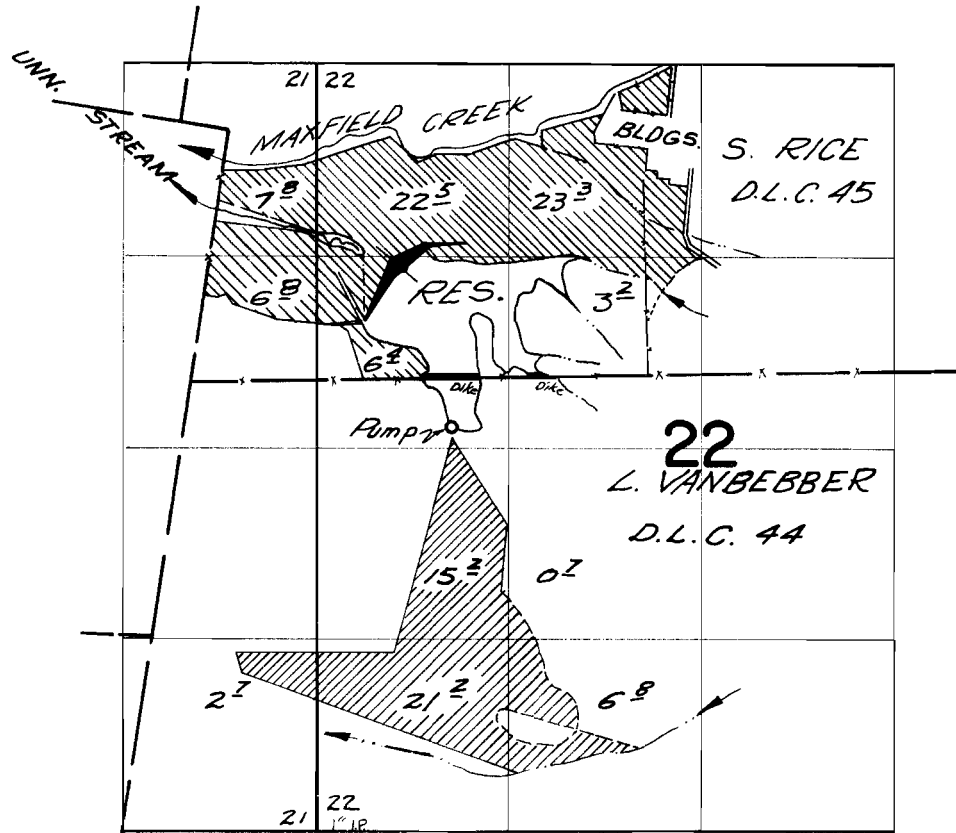

Div. Pt. located 3860 ft. N. & 600 ft. E. from the SW corner of section 22

FINAL PROOF SURVEY UNDER

R-35052 R-2862
 35053 27920
 Application No. 37298 Permit No. 27929
 IN NAME OF



EMERY E. MOORE

Surveyed April 14, 1966, by V. GARNER