


# T.10 S. R. 6 W. W.M.

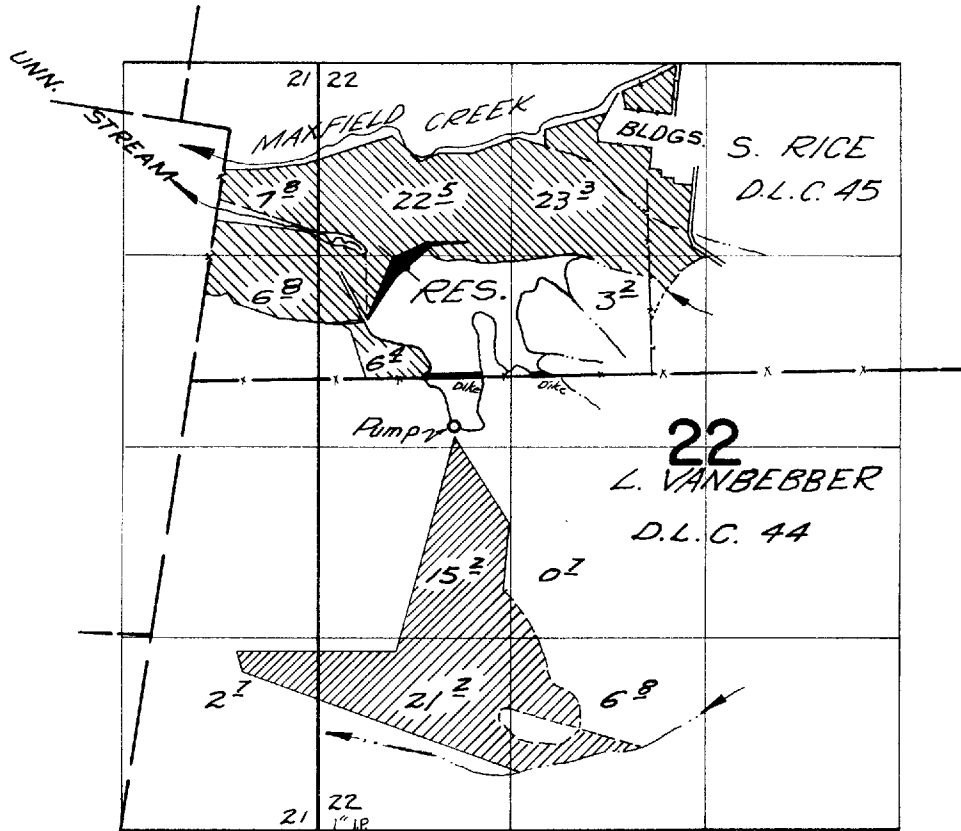

Div. Pt. located 3860 ft. N. & 600 ft. E. from the SW Corner of section 22

## FINAL PROOF SURVEY UNDER

R-35052                      R-2862  
 35053                      27920  
 Application No. 37298    Permit No. 27929  
 IN NAME OF



EMERY E. MOORE

Surveyed April 14, 1966, by V. GARNER