


T.2S.R.2E.W.M.

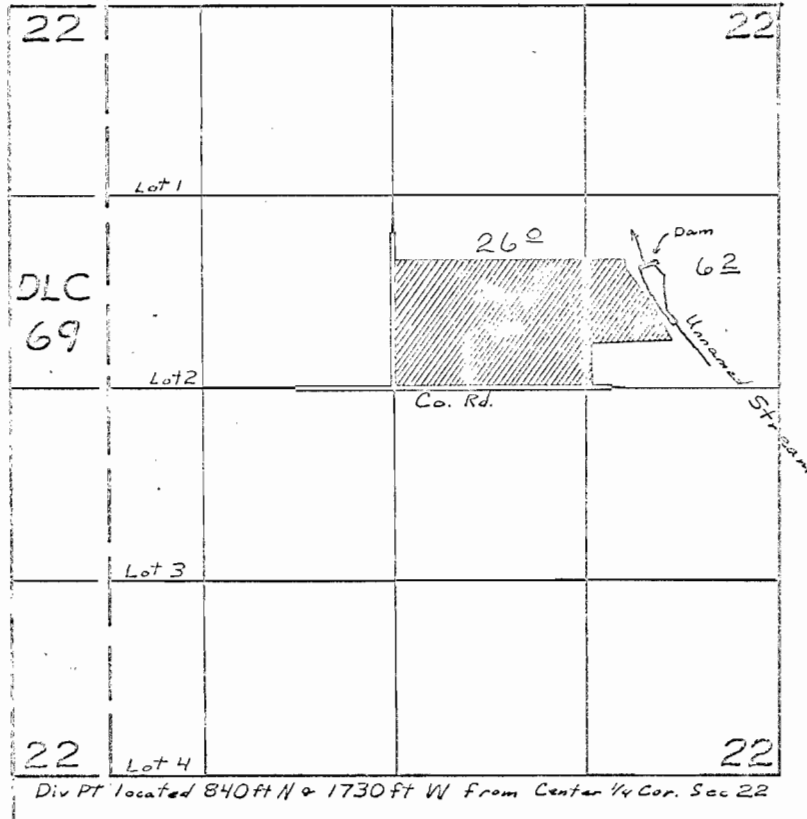

FINAL PROOF SURVEY  
UNDER

R-37698 R-2993  
Application No. 37699 Permit No. 28117  
IN NAME OF

E. J. Redmond

Surveyed May 31, 1967, by W. S. Ruppert.