


# T.2S.R.2E.W.M.

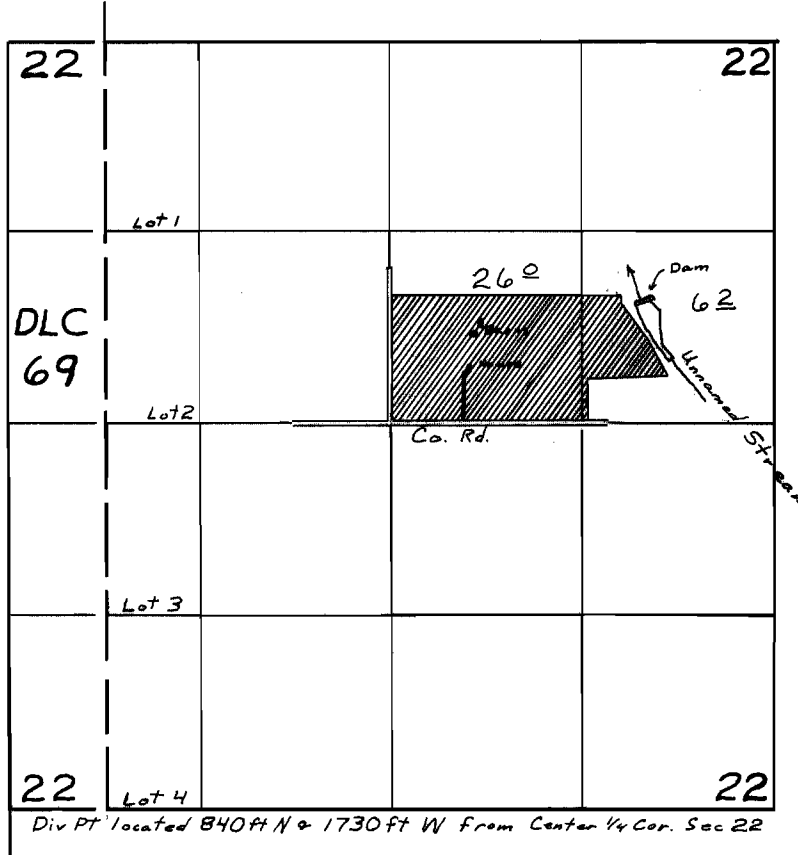

## FINAL PROOF SURVEY UNDER

R-37698 R-2993  
Application No. 37699 Permit No. 28117  
IN NAME OF

*E. J. Redmond*

Surveyed May 31, 1967, by *W. J. Ruppert*