


T.4S.R.2E.W.M.

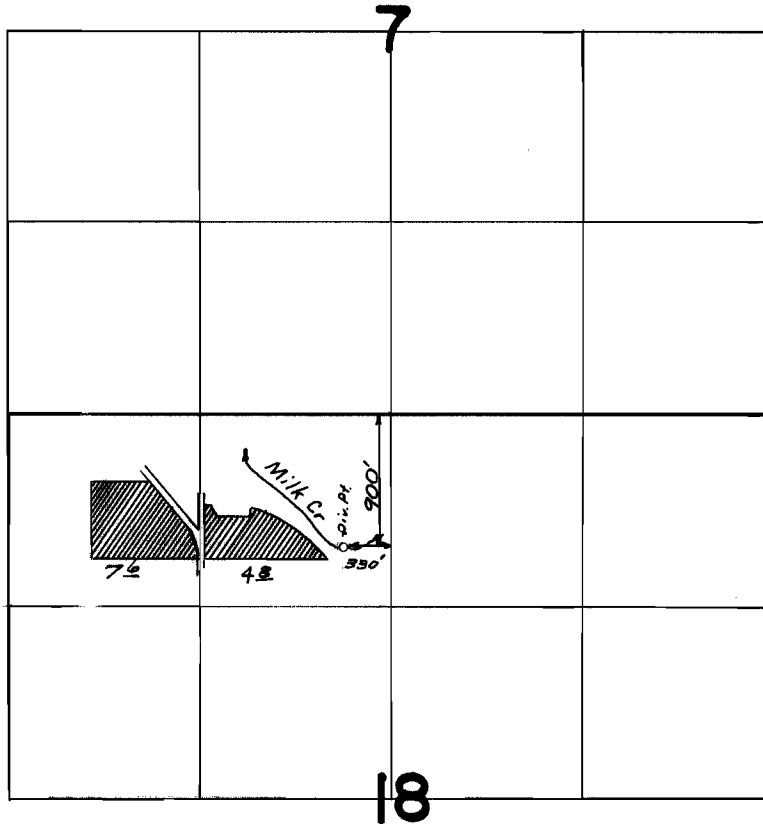

FINAL PROOF SURVEY UNDER

Application No. 39172 Permit No. 29219
IN NAME OF

Oscar Alber

Surveyed Oct. 17 1967, by W.J. Ruppert