


T. 7&8 N. R. 6 W. W. M.

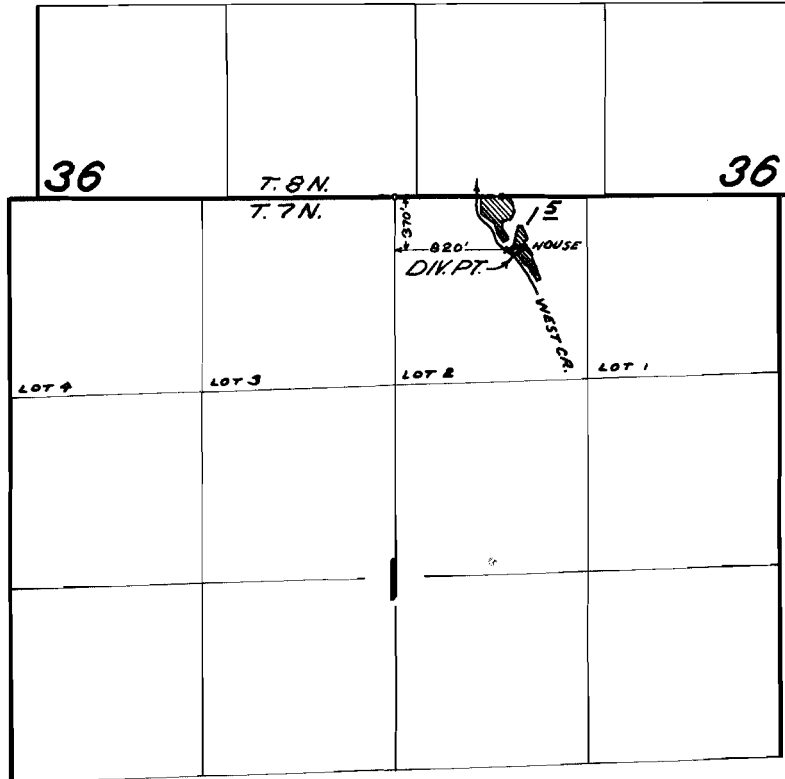

FINAL PROOF SURVEY
UNDER

Application No. 40960 Permit No. 30796
IN NAME OF

JACK M. SUTFIN

Surveyed AUG 16 1967, by V. GARNER