


T.4 N. R. 1&2 W. W.M.

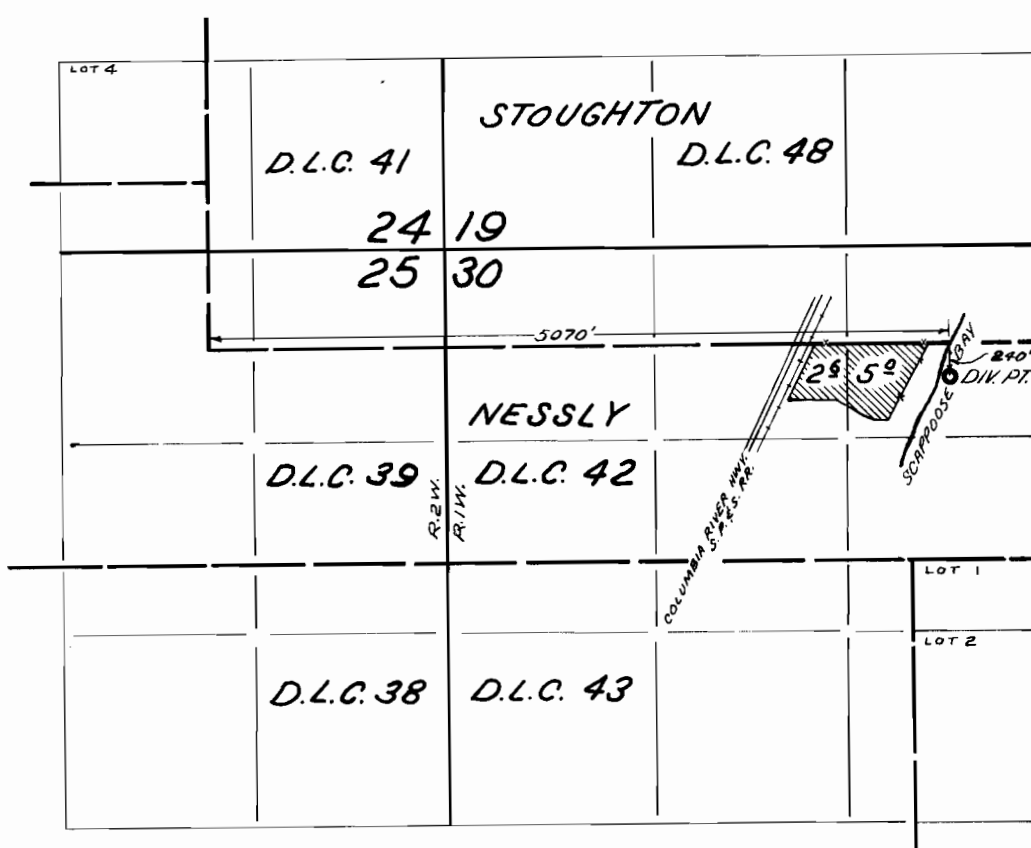

FINAL PROOF SURVEY UNDER

Application No. 30246 Permit No. 23947
IN NAME OF

HAROLD AND VELMA JOHNSON

Surveyed JUL 18 1967, by V. GARNER