


T. 3 N. R. 2 W. W. M.

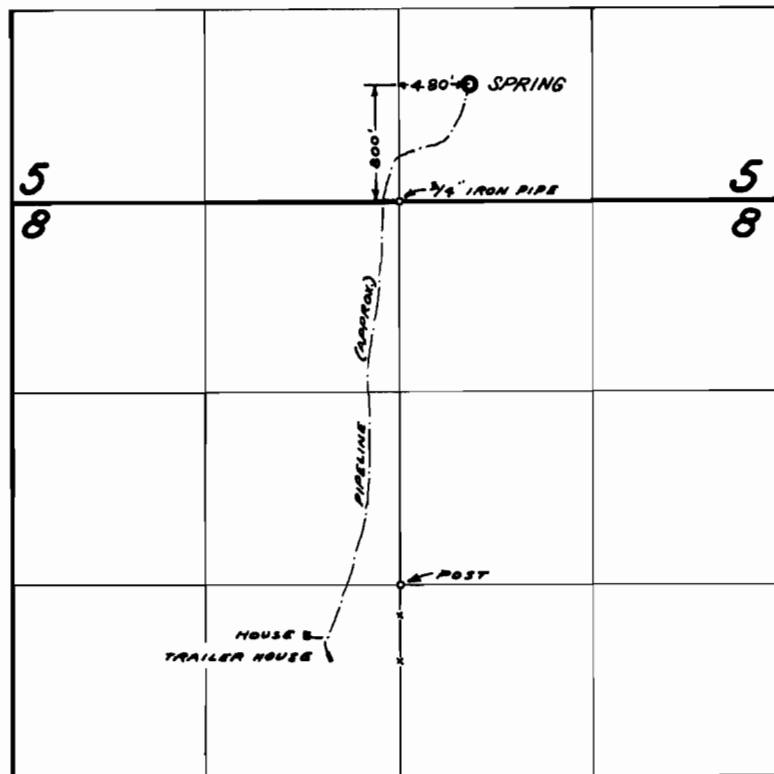


FINAL PROOF SURVEY
UNDER

Application No. 38889 Permit No. 28999
IN NAME OF

FRED RABINSKY

Surveyed JUL 18 1967, by V. GARNER

T. 3 N. R. 2 W. W. M.

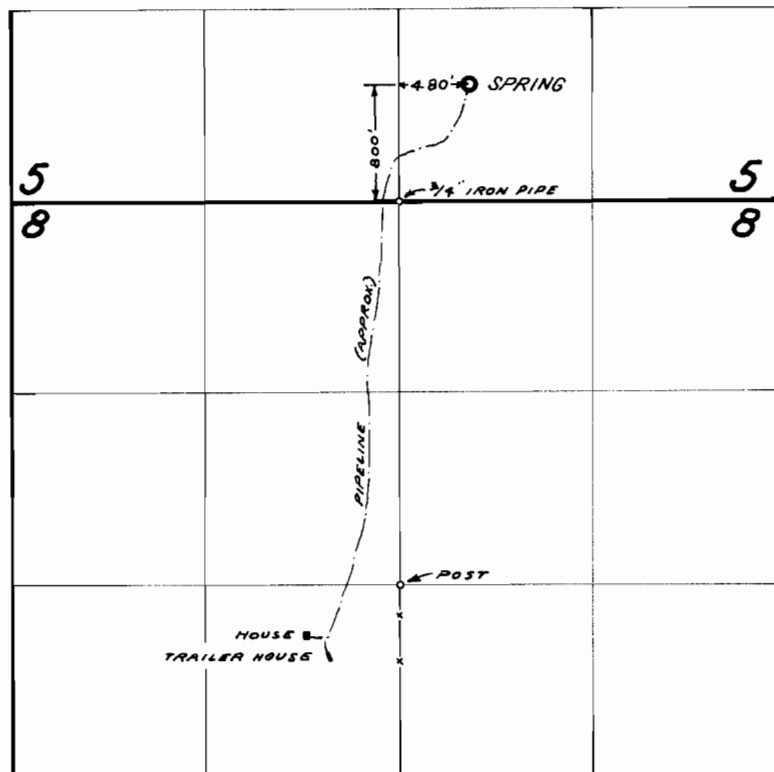

FINAL PROOF SURVEY
UNDER

Application No. 38889 Permit No. 28999
IN NAME OF

FRED RABINSKY

Surveyed JUL 18 1967, by V. GARNER