


T. 7 N. R. 4 & 5 W. W. M.

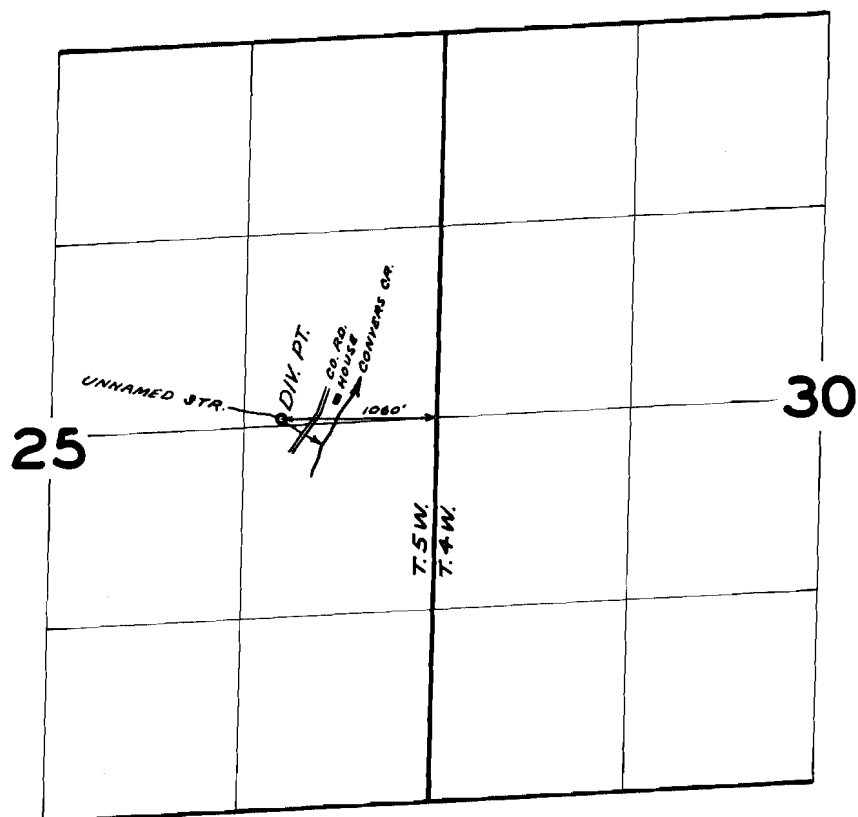

FINAL PROOF SURVEY
UNDER

Application No. 40385 Permit No. 30107
IN NAME OF

CHARLES ANTHONY PITZER

Surveyed AUG 14 1967, by V. GARNER