


T. 8 N. R. 3 W. W. M.

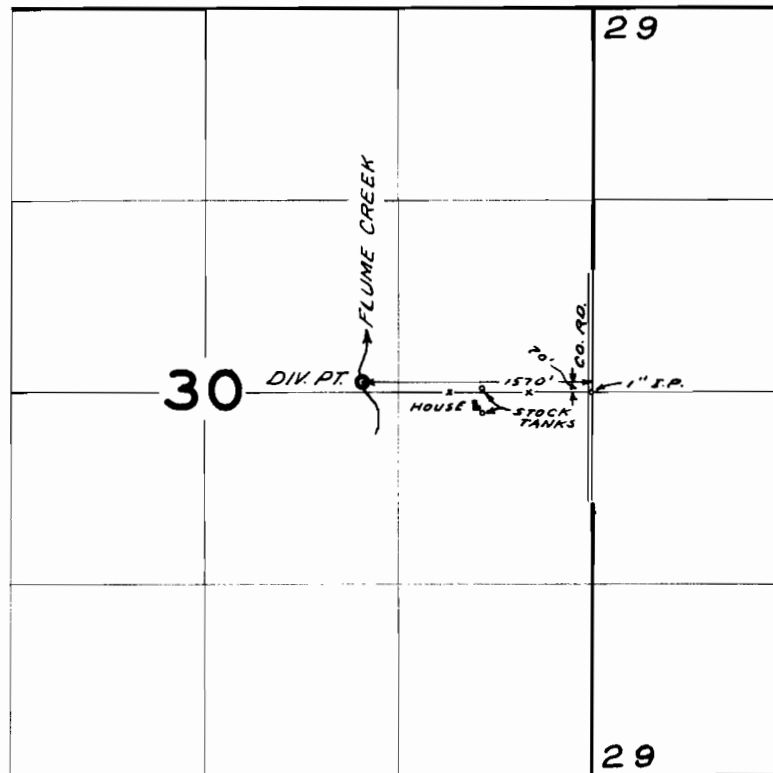

FINAL PROOF SURVEY
UNDER

Application No. 41060 Permit No. 30595
IN NAME OF

PAUL J. AND KERTTU I. JOLMA

Surveyed JUL. 19 1967, by V. GARNER