


T.3 N.R.2 W.W.M.

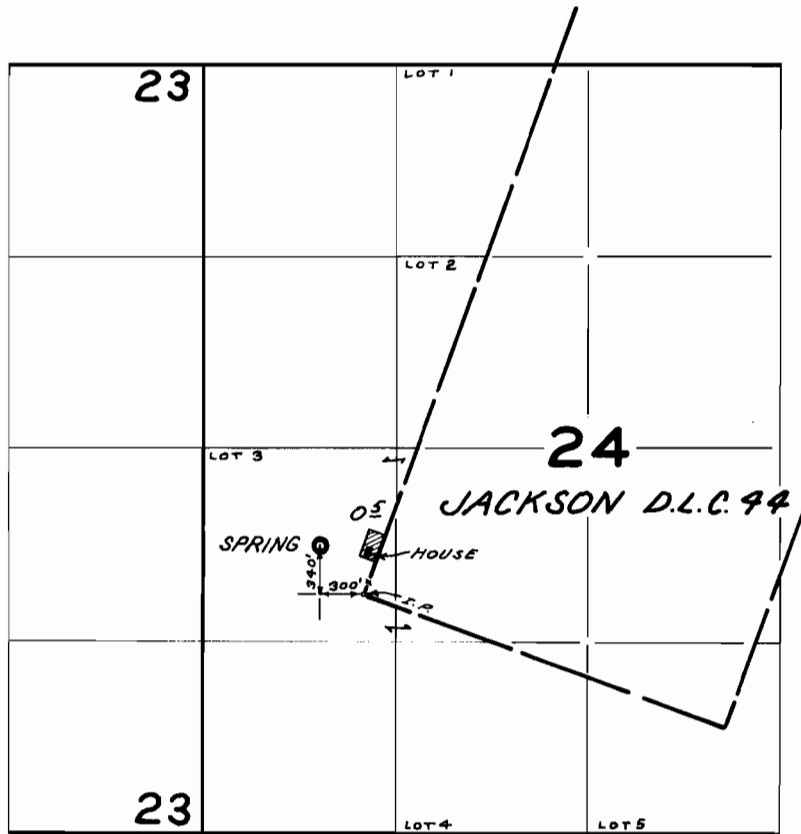

FINAL PROOF SURVEY
UNDER

Application No. 42400 Permit No. 31393
IN NAME OF

JAMES R. MEANS

Surveyed JUL. 21 1967, by V. GARNER