


T. 4 N. R. 2 W. W. M.

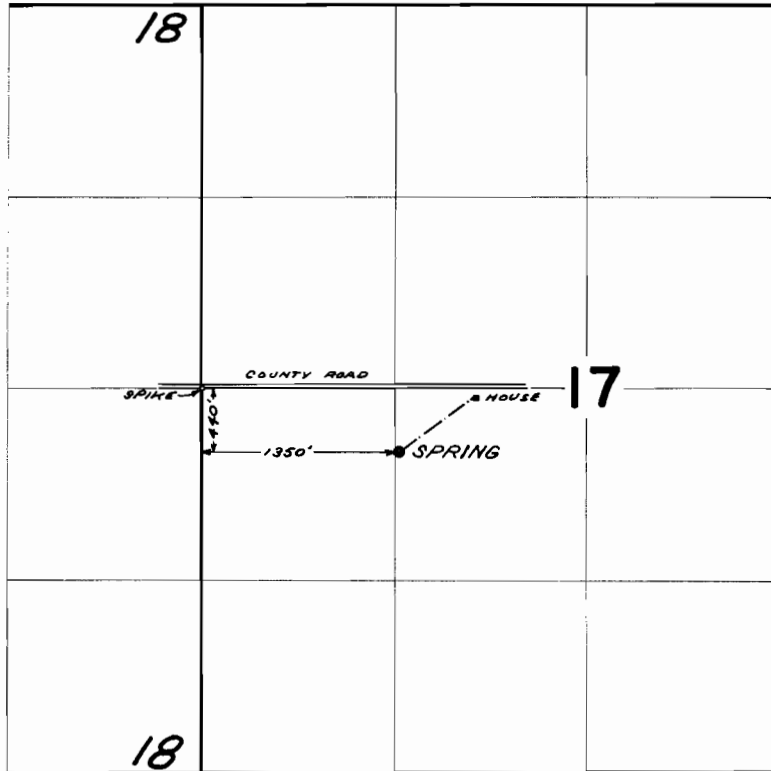

FINAL PROOF SURVEY
UNDER

Application No. 42869 Permit No. 32040
IN NAME OF

BURTON R. SMITH

Surveyed AUG. 17, 1967, by V. GARNER