


T. 33S. R. 1W. W.M.

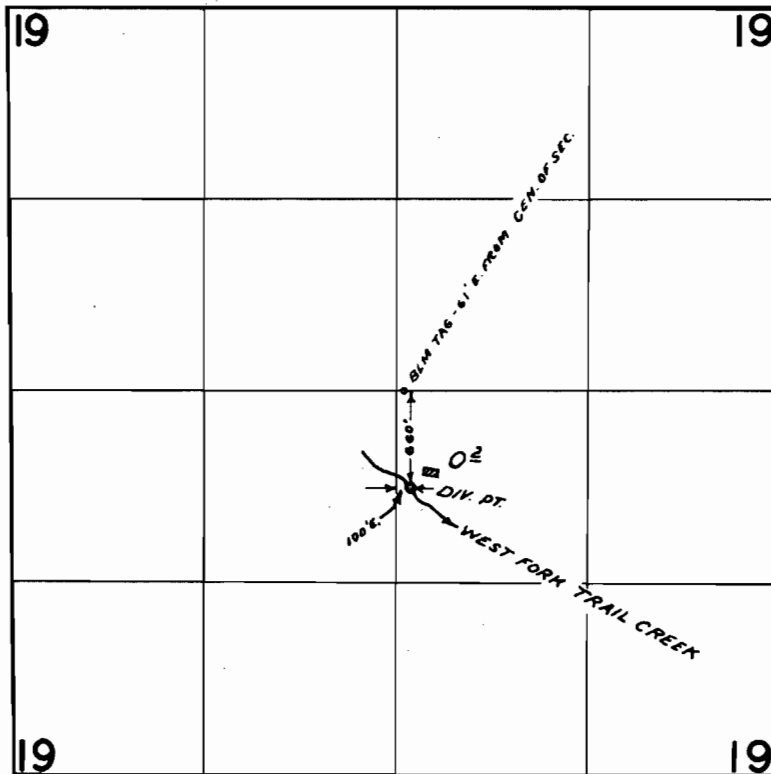

FINAL PROOF SURVEY
UNDER

Application No. 33263 Permit No. 26341
IN NAME OF

ALVA F. & BARBARA J. MUSE

Surveyed Jul. 15 1965, by C. GARDNER