


# T.36 S.R.1&2.W.W.M.

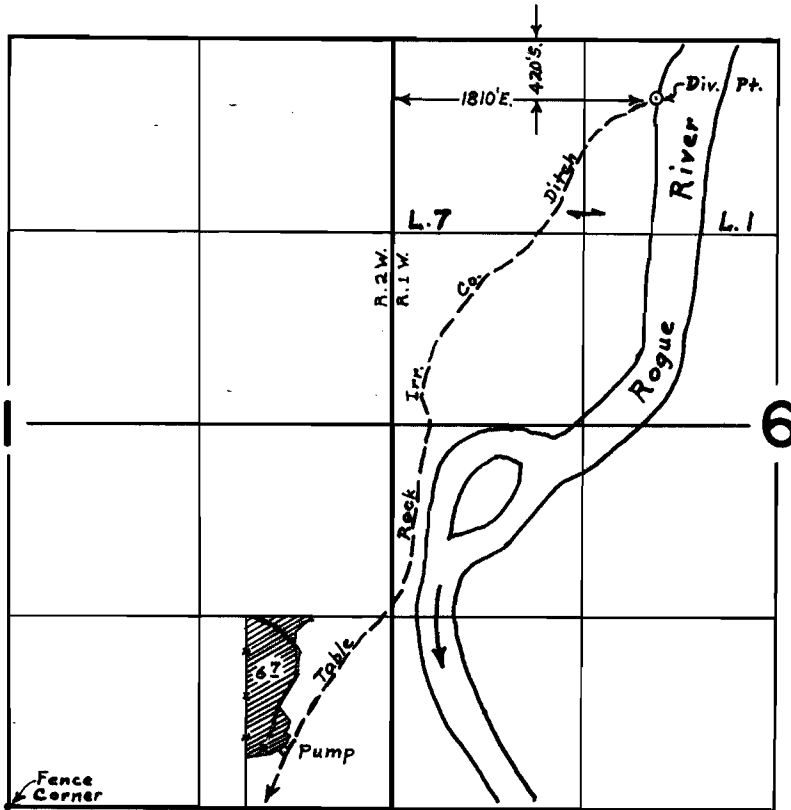

## FINAL PROOF SURVEY UNDER

Application No. 37717 Permit No. 28120  
IN NAME OF

JAMES A. LEWIS

Surveyed June 2, 1966, by L.E. Gould  
February 14, 1968, by D.L. Hendrix