


# T. 40 S. R. 11 E. W.M.

*Just River Wells*

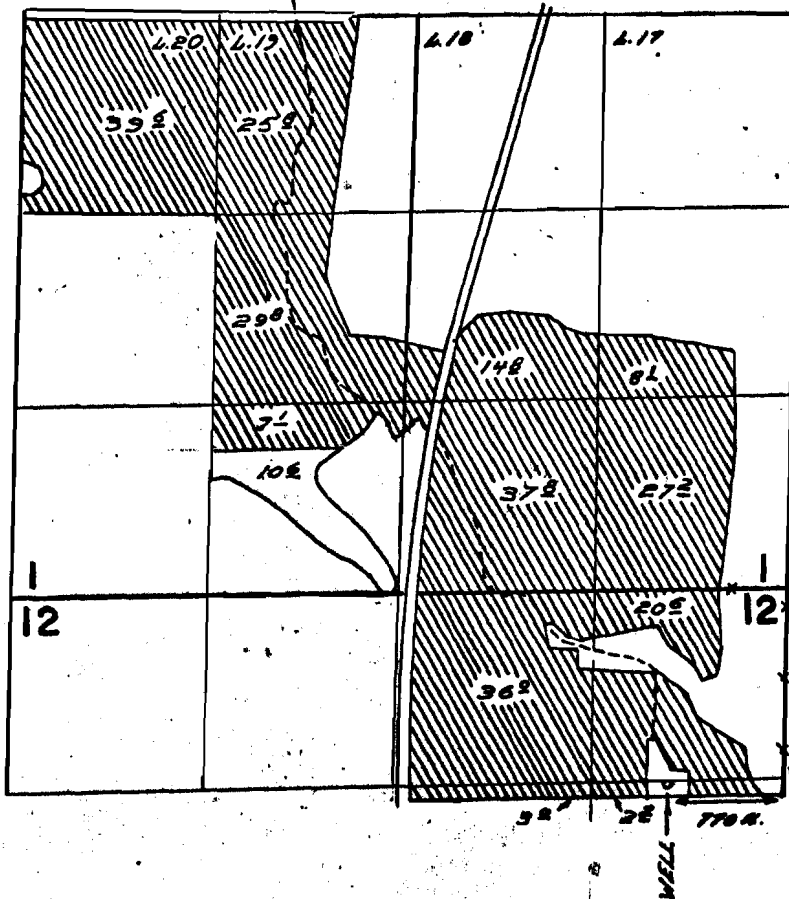

## FINAL PROOF SURVEY UNDER

Application No. *G-2138* Permit No. *G-1975*  
IN NAME OF

*William J. Rajnus, Jr.*

Surveyed *Mar. 1*, 1966, by *W.J. Ruppert*