


R-3132
34769

T.40S. R.13E.W.M.

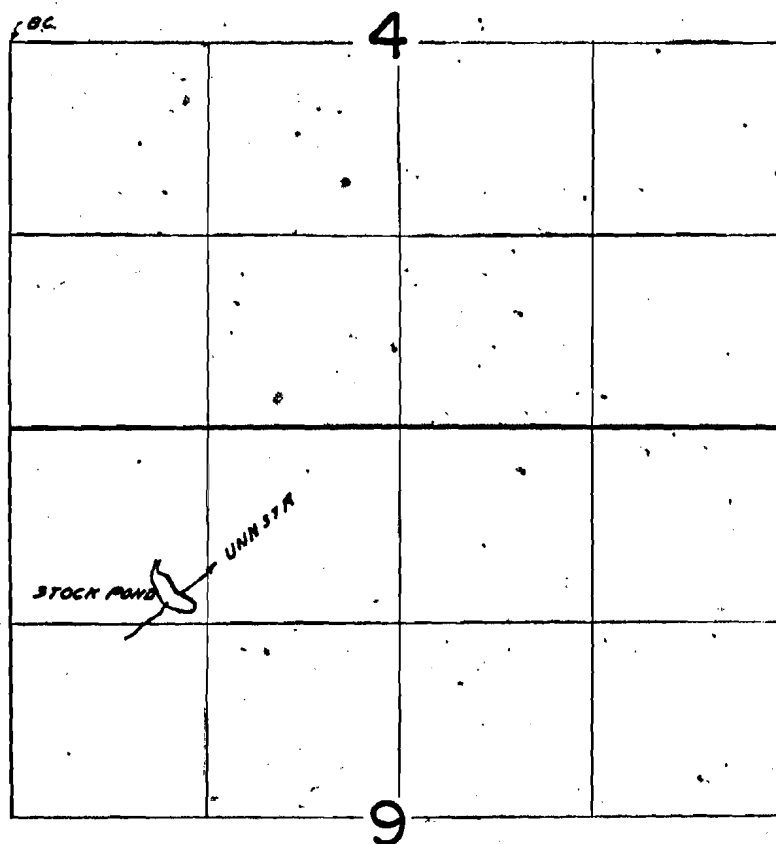

FINAL PROOF SURVEY
UNDER

Application No. R-37113 Permit No. R-3132
IN NAME OF

Myron W. Dearborn

Surveyed Oct. 6 1966, by W.J. Ruppert