


T.39S.R.11E.W.M.

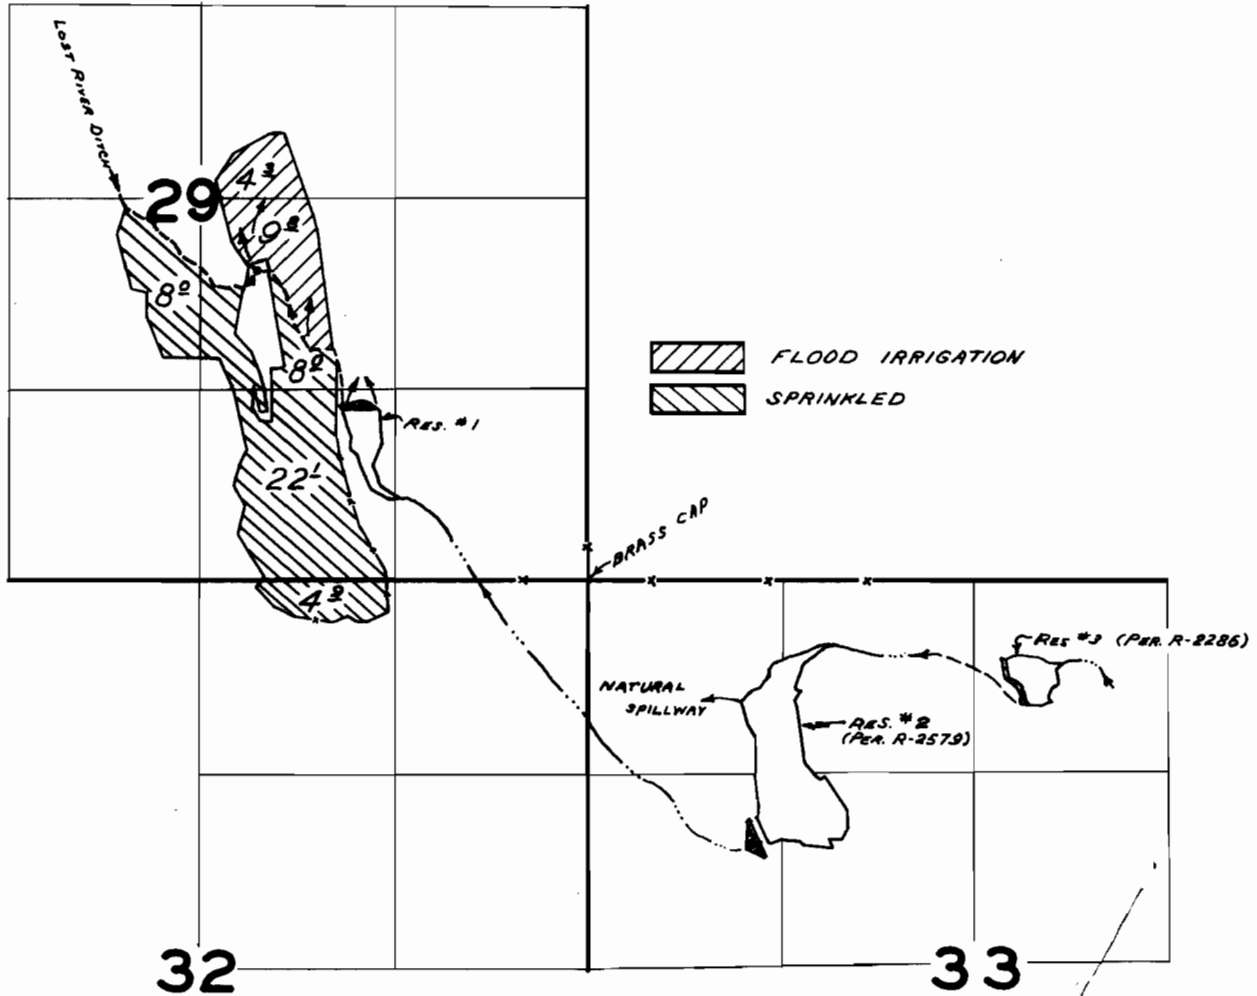

FINAL PROOF SURVEY UNDER

Application No. R-33300 Permit No. R-2286
33301 26405
R-34491 R-2579
34492 27136

IN NAME OF

R. T. WILLIAMS

Surveyed Jun 16 1964 by R. JACKSON