


26405  
34771

# T.39S.R.11E.W.M.

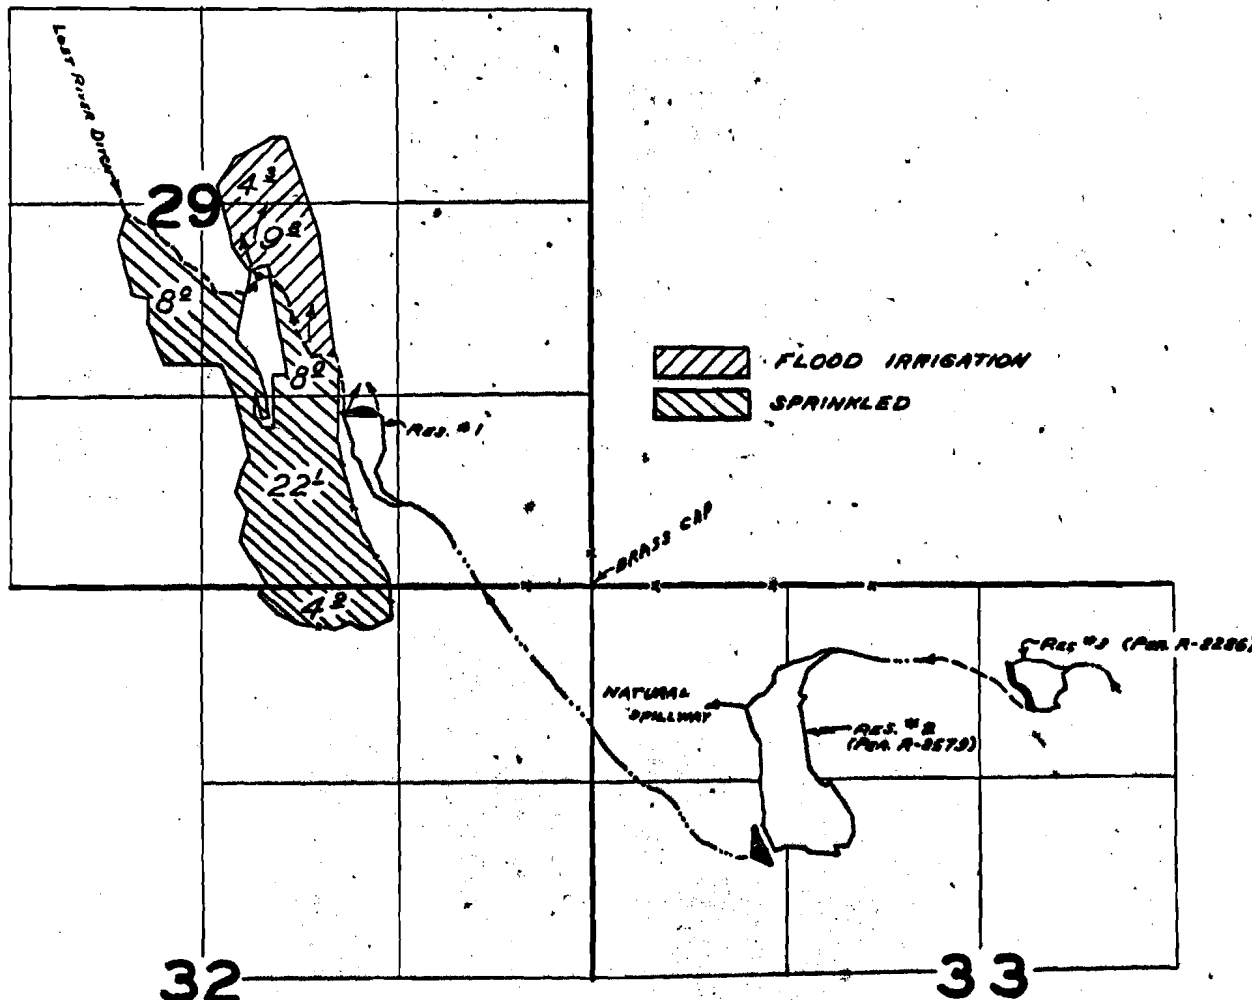


## FINAL PROOF SURVEY UNDER

	R-3330	R-2286
	3330/	26405
Application No.	R-3449/	R-2579
	34492	27136

IN NAME OF

R. T. WILLIAMS

Surveyed Jun 16 1964, by R. JACKSON