


T.36S. R.12 E.W.M.

Sycan Co. below Sycan Marsh

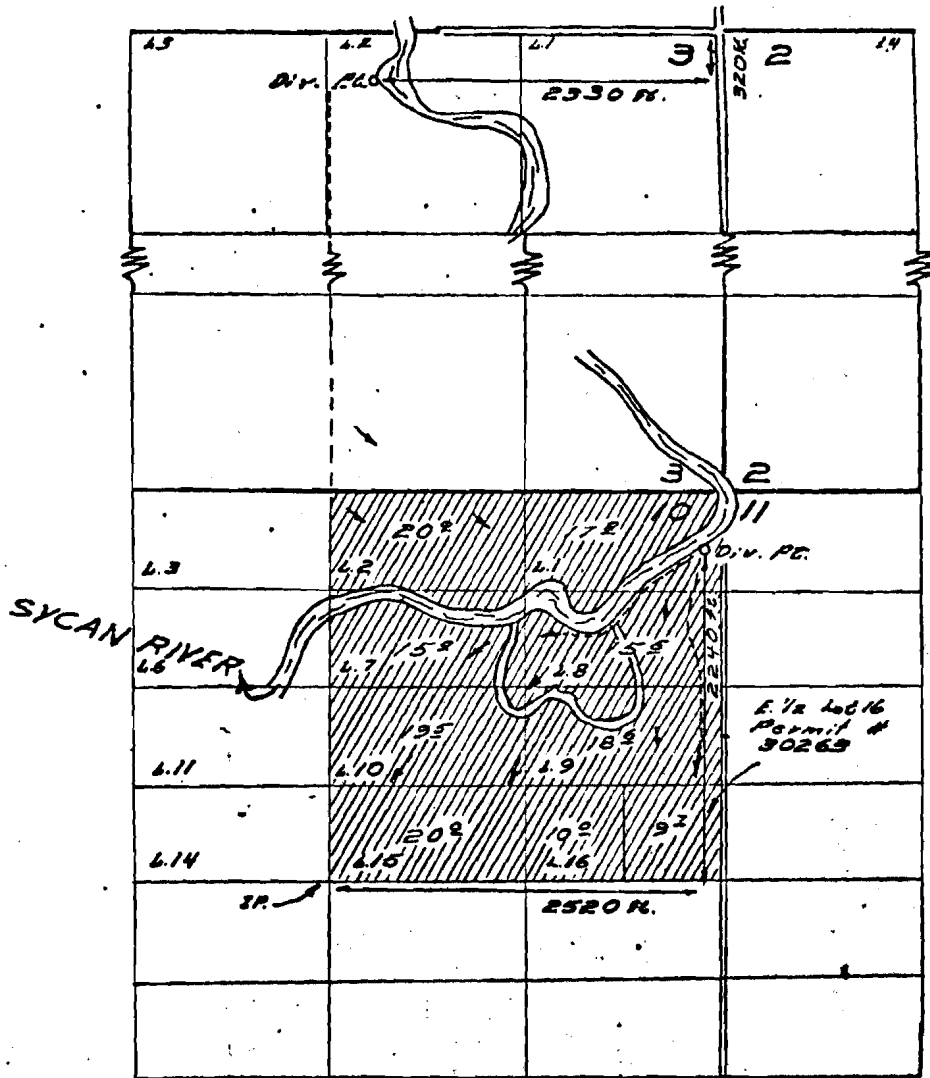

FINAL PROOF SURVEY UNDER

Application No. 33994 Permit No. 26785
40412 Permit No. 30263
IN NAME OF

HOMER A. & INEZ V. DELAMATER

Surveyed Oct. 11, 1966 by W. J. Ruppert