


T.39S.R.11E.W.M.

East River Misc.

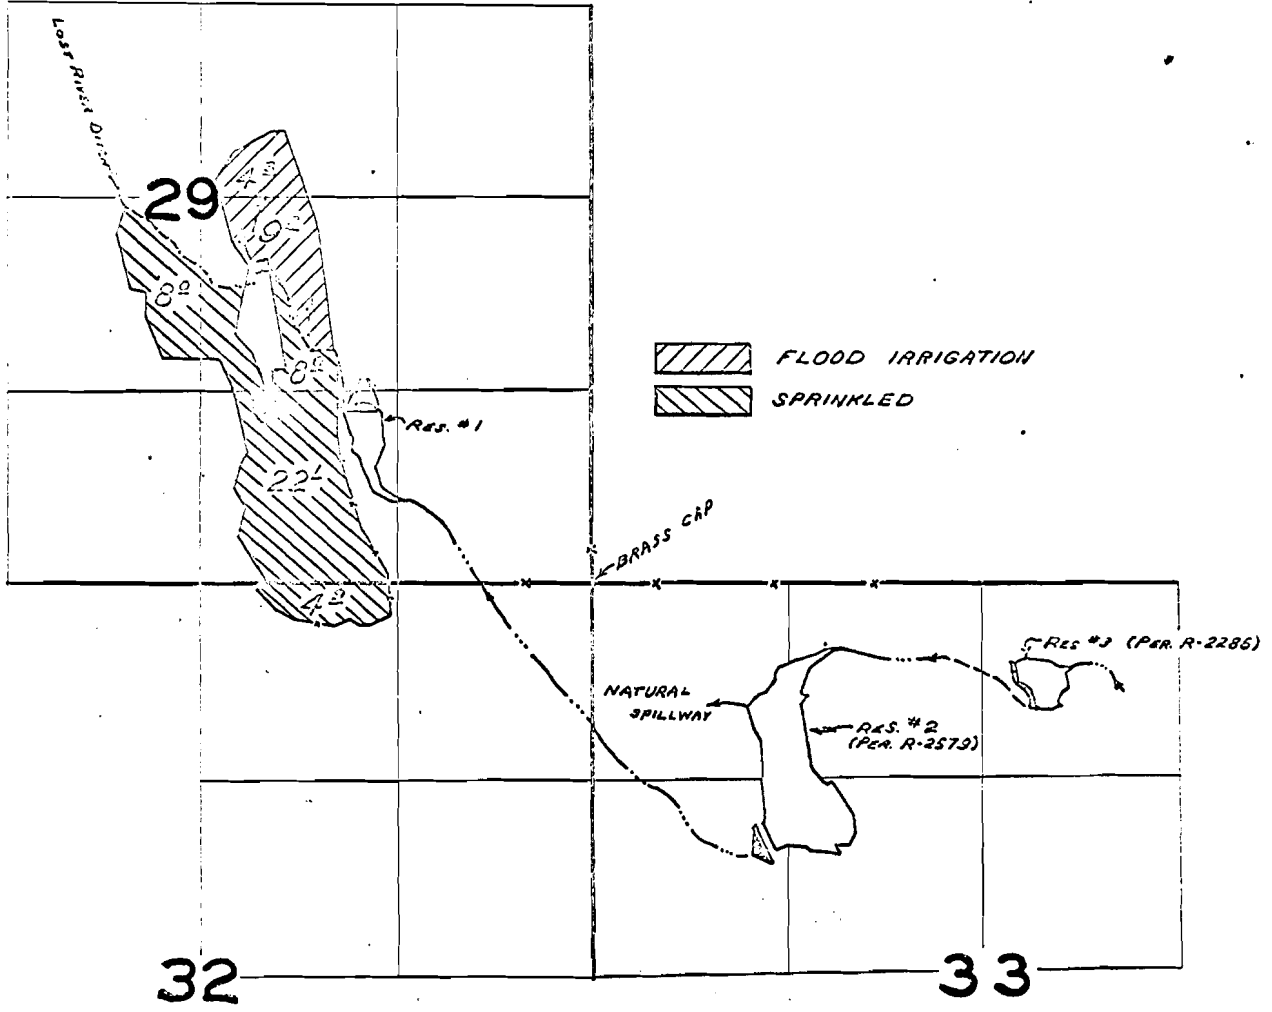

FINAL PROOF SURVEY UNDER

Application No. R-33300 Permit No. R-2286
33301 26705
R-34491 R-2579
34792 27136

IN NAME OF

R. T. WILLIAMS

Surveyed JUN 16 1964 by R. JACKSON