


T. 36 S. R. 12 E. W. M.

Sycan to below Sycan Marsh

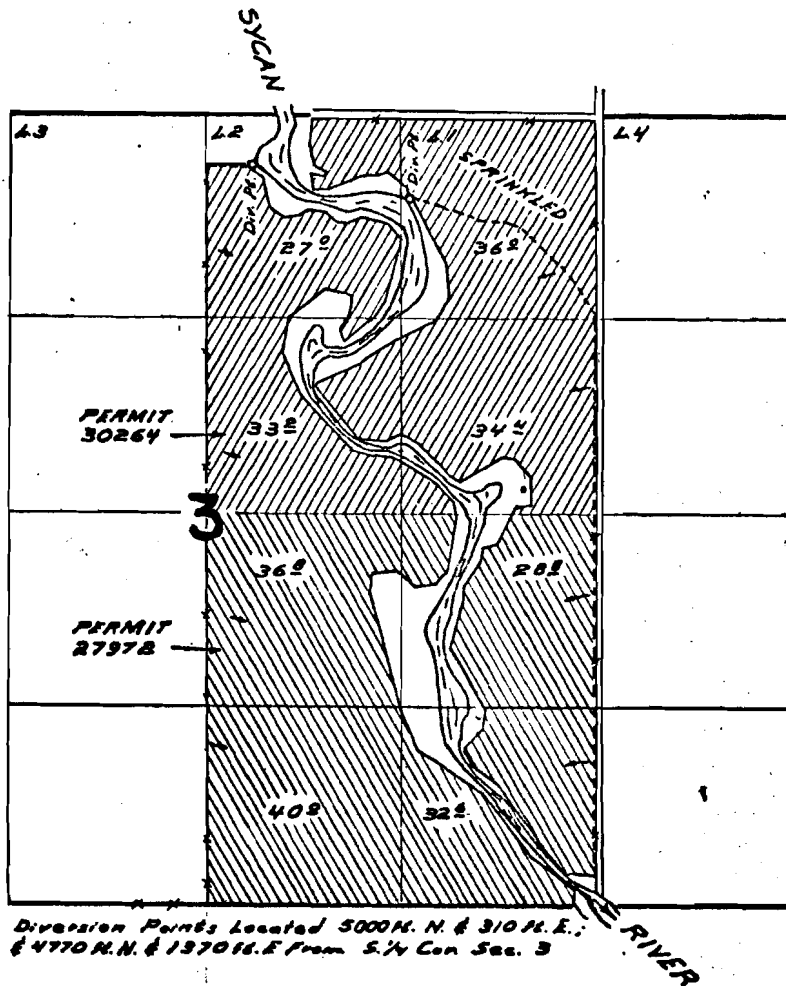

FINAL PROOF SURVEY UNDER

40413 30264 ✓
 Application No. 37534 Permit No. 27972
 IN NAME OF
Homer A. & Inez V. DeLamater.
 Surveyed Oct. 11, 1966, by W. J. Ruppert