30267
34777

Sycan R. blw. Sycan Marsh

T. 36 S. R. 12 E. W. M.

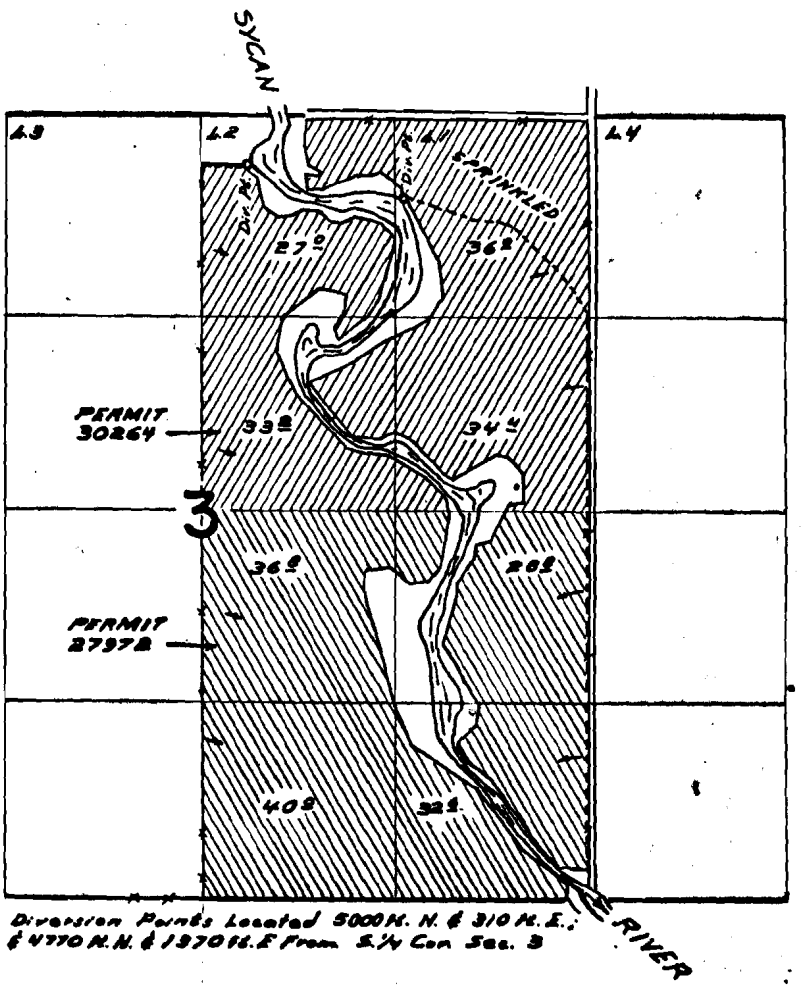

FINAL PROOF SURVEY
UNDER

Application No. 37534 (40413) Permit No. 27972 (30264)
IN NAME OF

Homer A. & Inez V. DeLamater

Surveyed Oct. 11. 1966, by W. J. Ruppert