


T.16S. R.4.W.W.M.

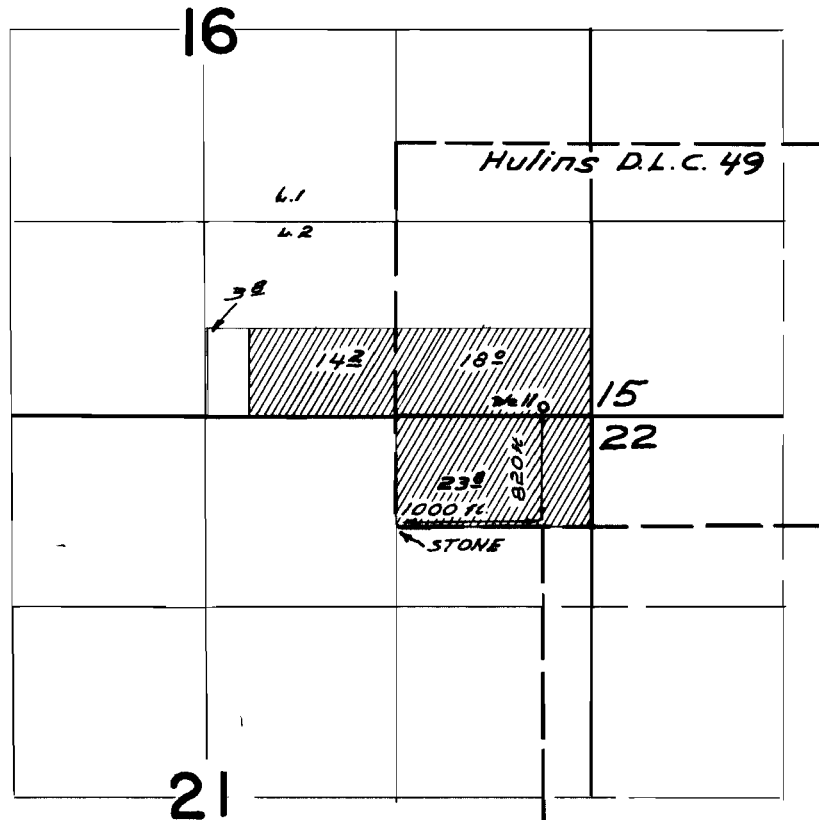

FINAL PROOF SURVEY
UNDER

Application No. G-2169 Permit No. G-2000
IN NAME OF

ESTATE OF RUBY W. DUNN

Surveyed May 16 1966, by W.J. Ruppert