


T.16S.R.4W.W.M.

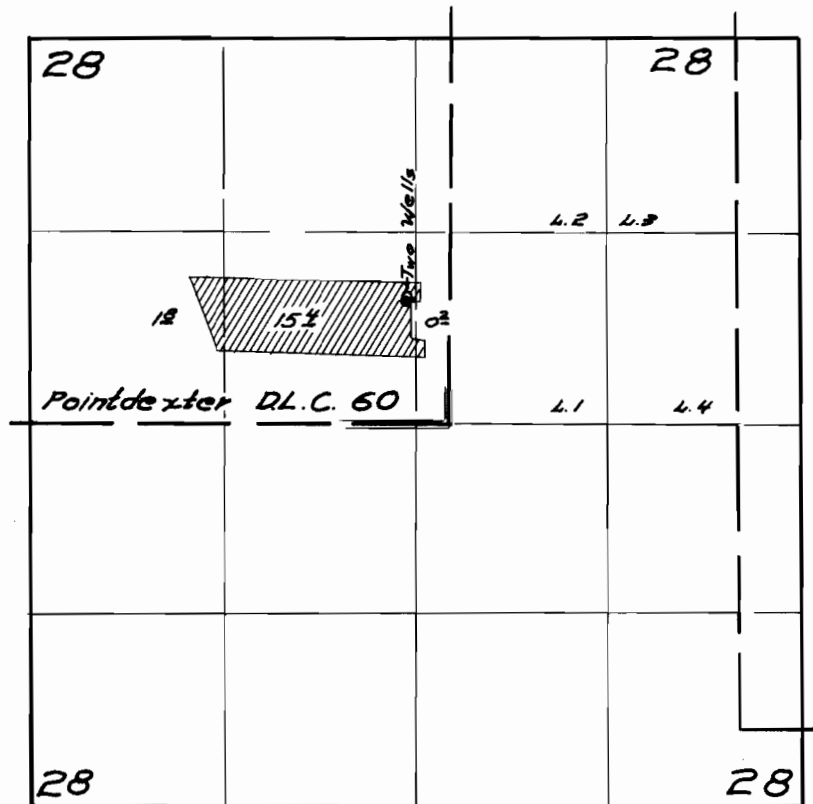

Wells located 850 ft. N.E. 300 ft. W. and 870 ft. N.E. 300 ft. W. from S.E. cor. D.L.C. 60

FINAL PROOF SURVEY
UNDER

Application No. G-2446 Permit No. G-2248
IN NAME OF

ROBERT MARKER

Surveyed May 17 1966, by W.J. Ruppert