


# T.18S. R.2&3 W. W.M.

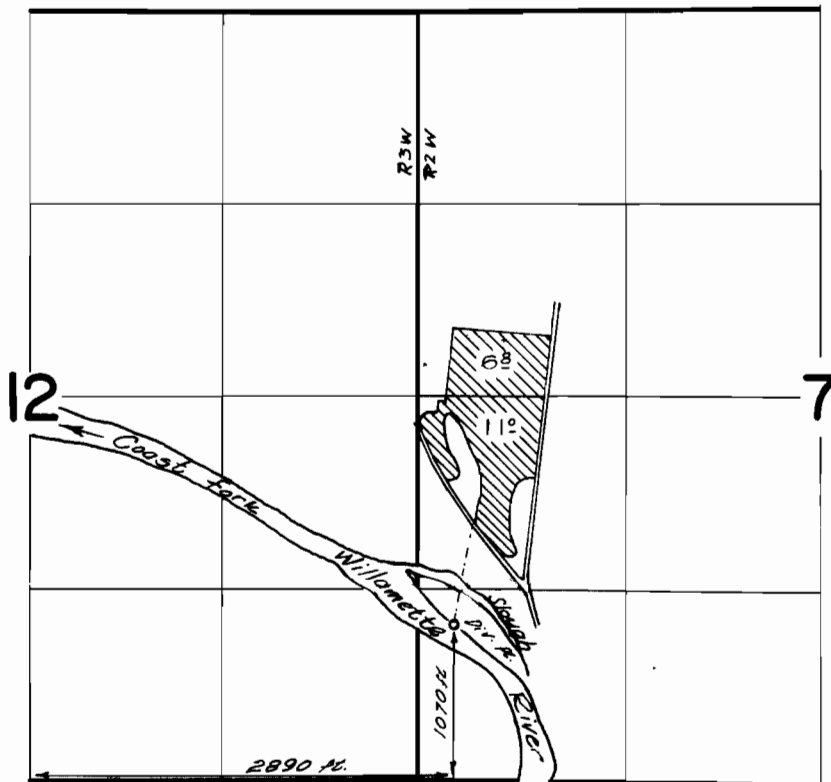

## FINAL PROOF SURVEY UNDER

Application No. 34841 ... Permit No. 27351 ...  
IN NAME OF

KENNETH I. KIENZLE

Surveyed May 7, 1965, by *Ruppert*  
Sept 11, 1967 *W.J. Ruppert*