


T.17 S. R.9 W. W.M.

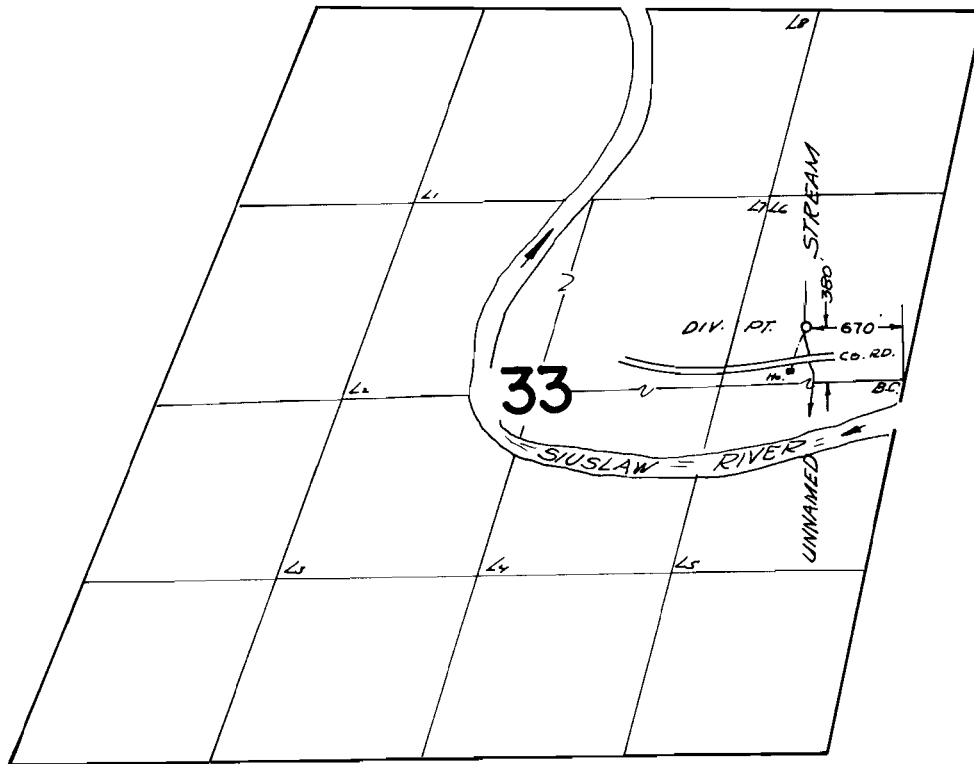

FINAL PROOF SURVEY
UNDER

Application No. 42402 Permit No. 31667
IN NAME OF

BARNIE E. WILSON and ROSE M. WILSON

Surveyed July 14, 1967, by V. Garner