


T.17S. R.9W. W.M.

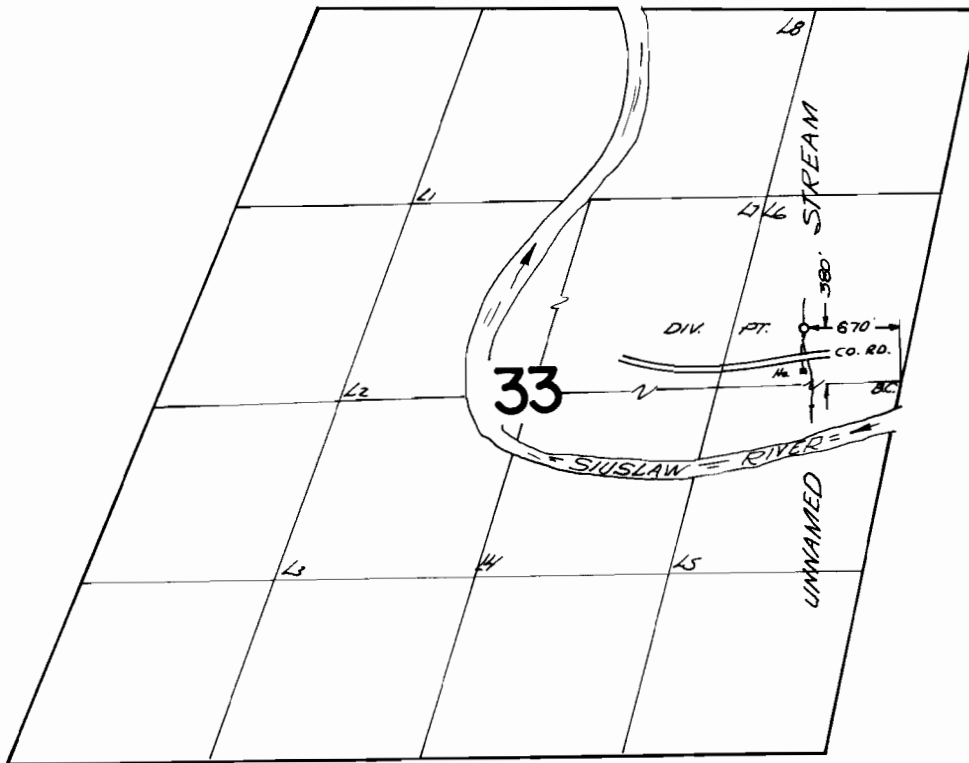

**FINAL PROOF SURVEY**  
UNDER

Application No. 42403 Permit No. 31668  
IN NAME OF

WILBERT A. KILFOY and BERTHA E. KILFOY

Surveyed July 14, 1967, by V. Garner