


T.11S.R.2W.W.M.

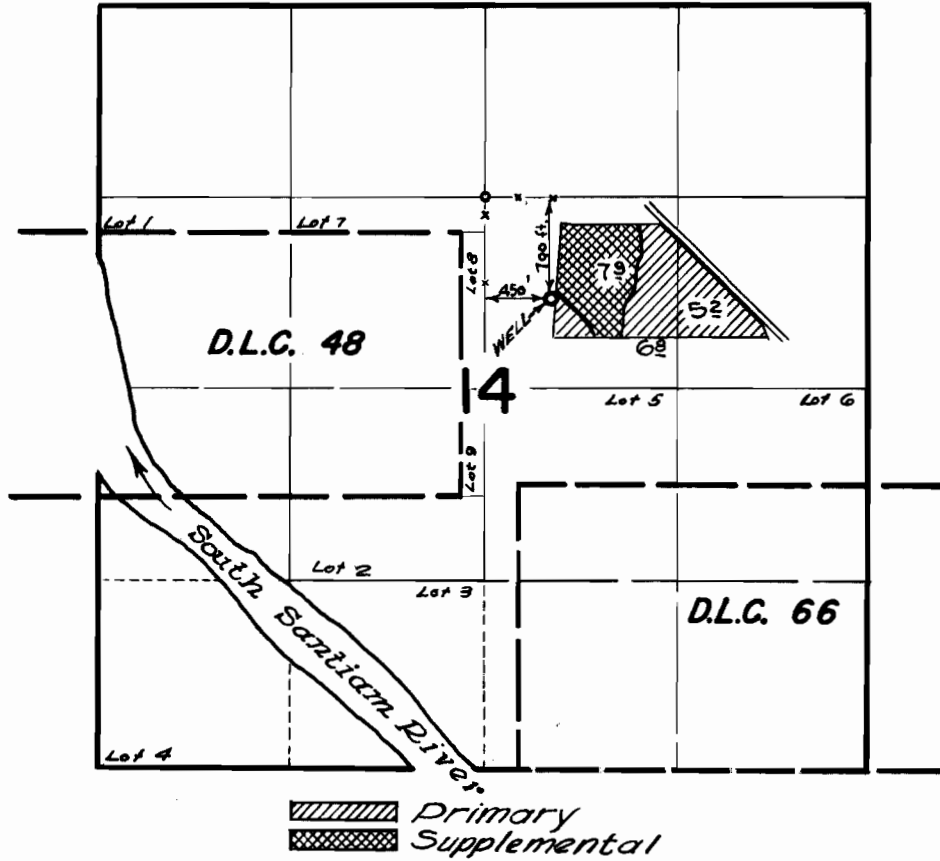

**FINAL PROOF SURVEY**  
UNDER

Application No. G-3171... Permit No. G-2982..  
IN NAME OF

**RUSSELL C. & HELEN L. FALK**

Surveyed April 6, 1966, by *R. Jackson*