


T. 21 S. R. 46 E. W. M.

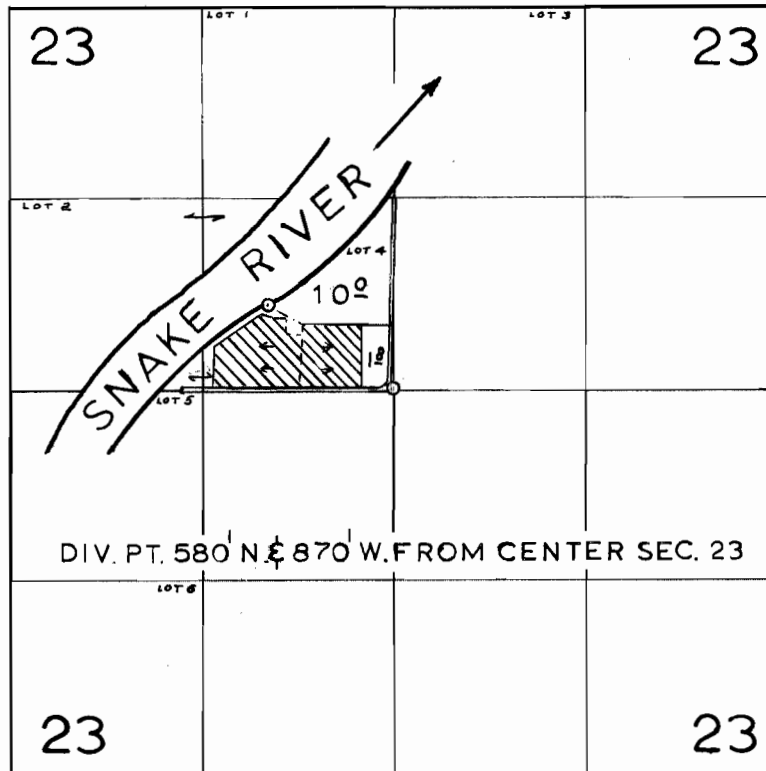

FINAL PROOF SURVEY
UNDER

Application No. 39159 Permit No. 29132

IN NAME OF

RICHARD D. DAVIS

Surveyed MARCH 21 1966, by F. ELFERING