


T.18 S. R. 46 E. W.M.

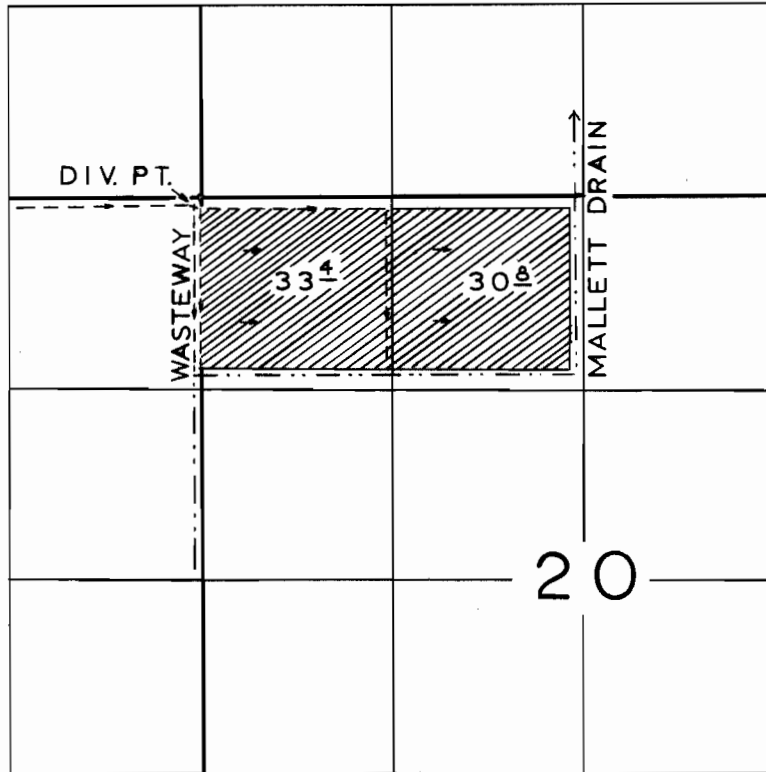

DIV. PT. IS 70'S. & 20'W. FROM NW COR. SEC. 20

FINAL PROOF SURVEY
UNDER

Application No. 39416 Permit No. 29374

IN NAME OF

HAROLD MALLETT

Surveyed OCT. 31. 1967., by F.ELFERING