


T.15 S. R. 47 E. W.M.

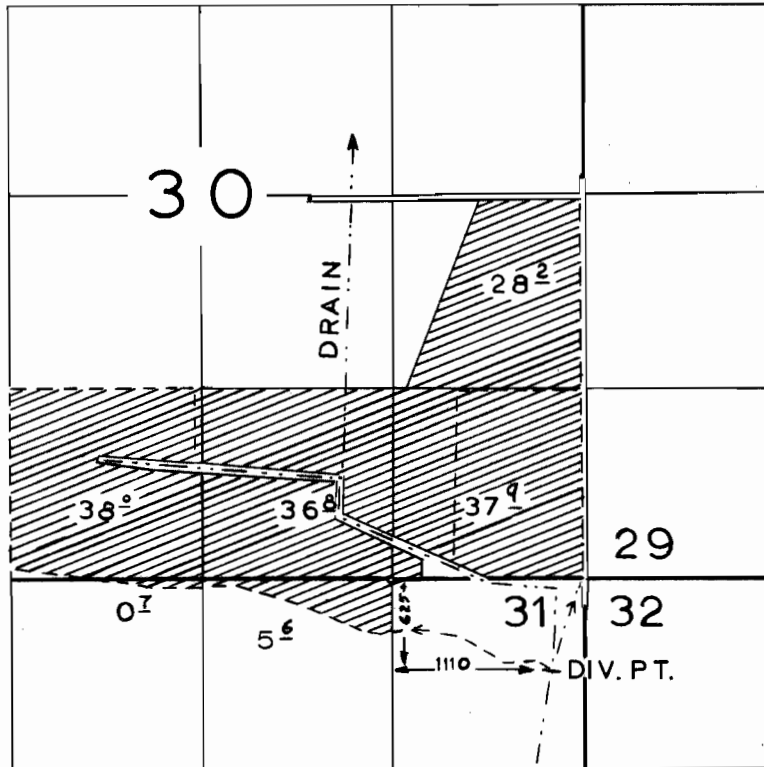

**FINAL PROOF SURVEY**  
UNDER

Application No. 38073 Permit No. 29760  
IN NAME OF

HARRY G. AND PEARL R. FRASIER

Surveyed OCT. 19 1967, by FELFERING