


ORIENTATION OF THIS
APPEARS TO BE ROTATED
APPROX. 3° COUNTER CLOCKWISE
FROM WHAT IT SHOULD BE

See file G-5754

.R.42 E.W.M.

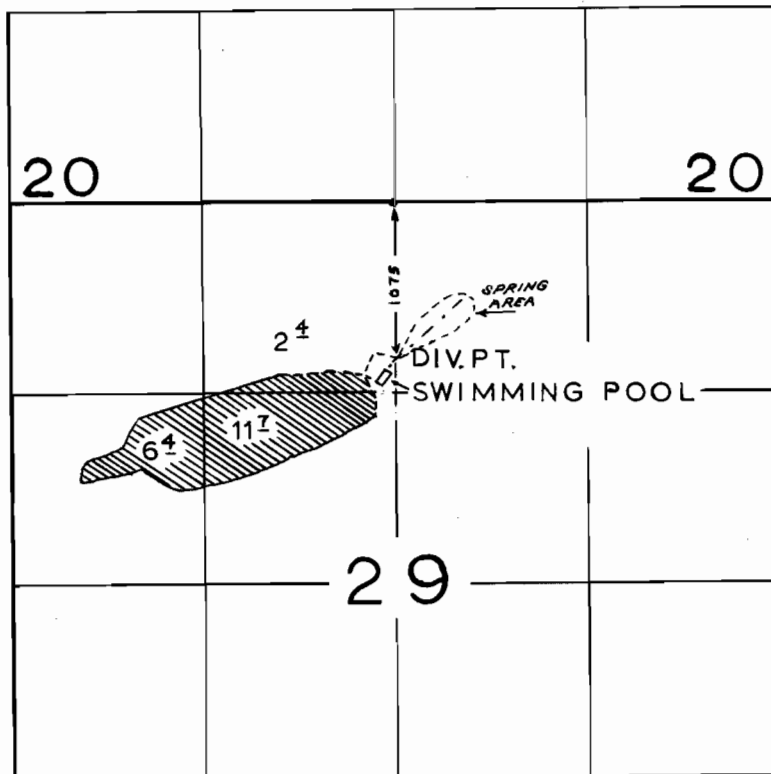

FINAL PROOF SURVEY
UNDER

Application No. 41014 Permit No. 30579
IN NAME OF

TOM J. DONALDSON

Surveyed OCT. 20 1967, by F.ELFERING