T.6S. R.2W. W. M.

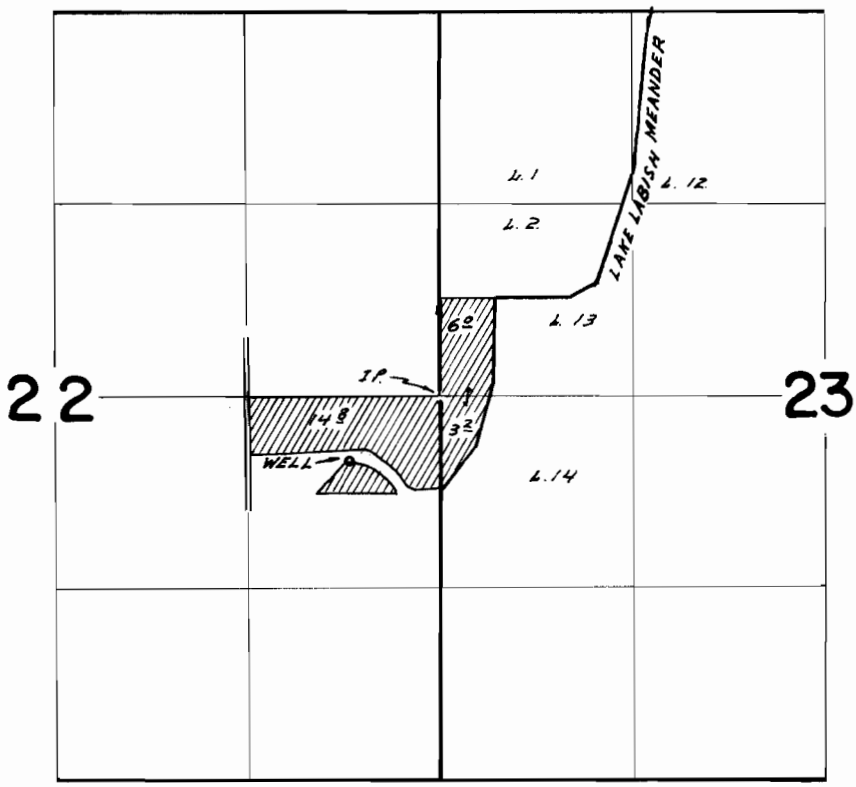

WELL LOCATED 440 ft. S & 620 ft. W. FROM E 1/4 COR. SEC. 23

FINAL PROOF SURVEY
UNDER

Application No. G-2360 Permit No. G-2200
IN NAME OF

Odin Hollin

Surveyed Aug. 18 1966, by W.J. Ruppert

DPN-20-70