


# T.6S. R.2&3W. W.M.

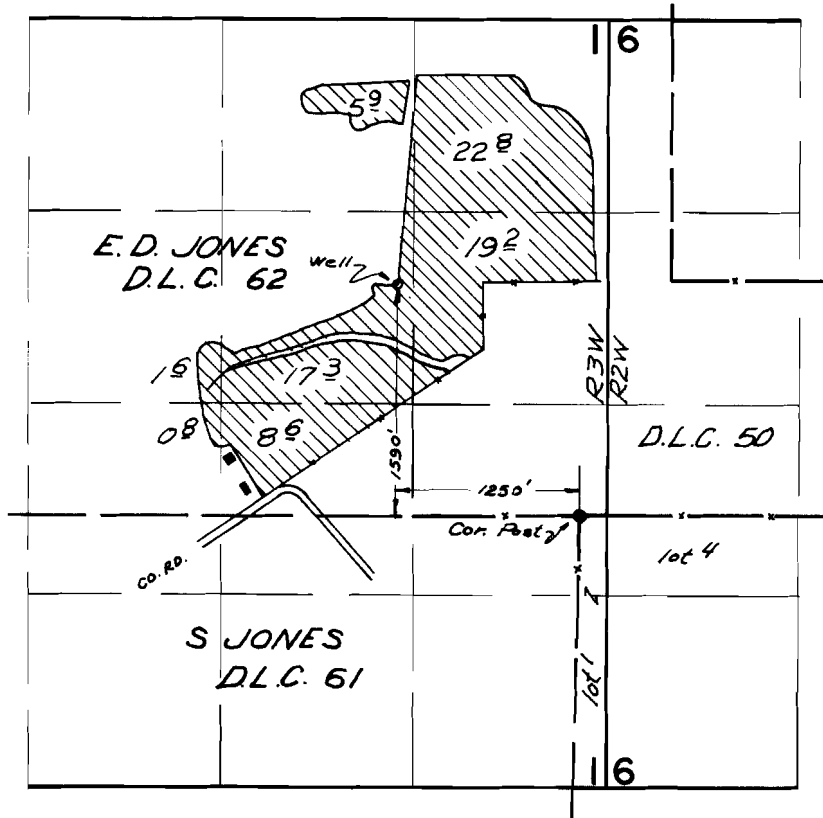

## FINAL PROOF SURVEY UNDER

Application No. G-2822 Permit No. G-2625  
IN NAME OF

STUART J. COUPER

Surveyed July 8, 1965, by DRB-L. Calabank  
by V.G.