


T.6S. R.1W. W.M.

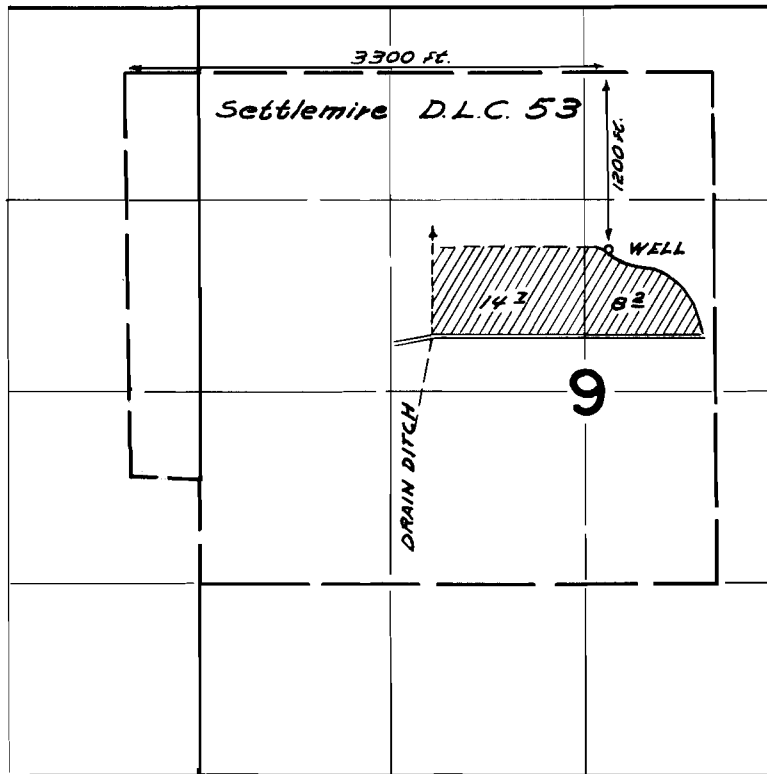

FINAL PROOF SURVEY UNDER

Application No. G-2870 Permit No. G-2667
IN NAME OF

W. C. & J. N. Severin

Surveyed July 29 1966, by W. V. Ruppert