


T.7S. R.2W. W.M.

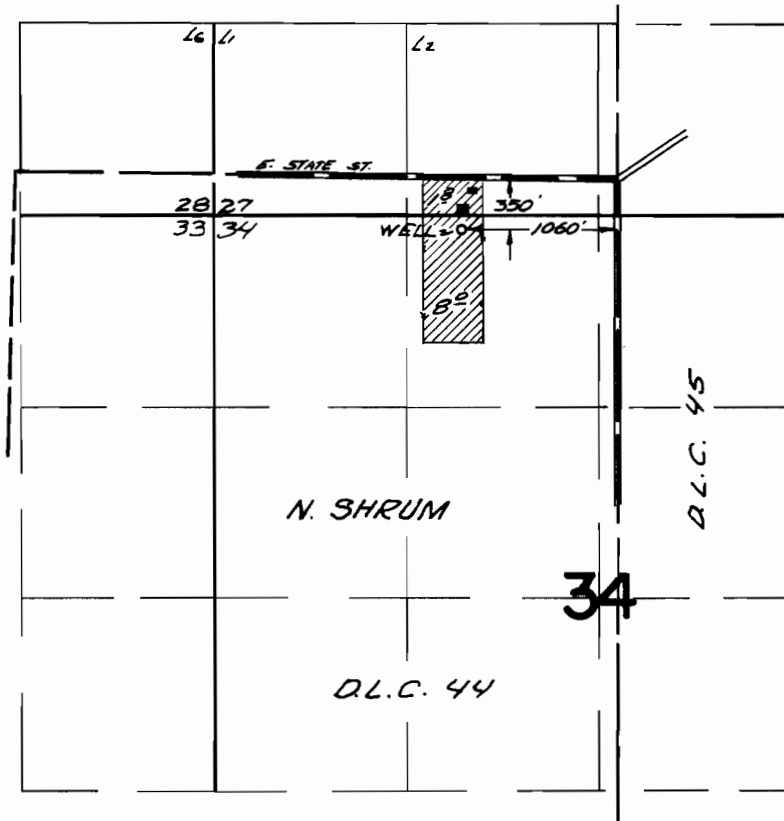

FINAL PROOF SURVEY
UNDER

Application No. ~~G:3366~~ Permit No. ~~G:3172~~
IN NAME OF

LYMAN R. DEHUT

Surveyed Nov. 20, 1967, by V. Garner