


R-4542/
30207/
34800

T. 3S.R.25E. W.M.

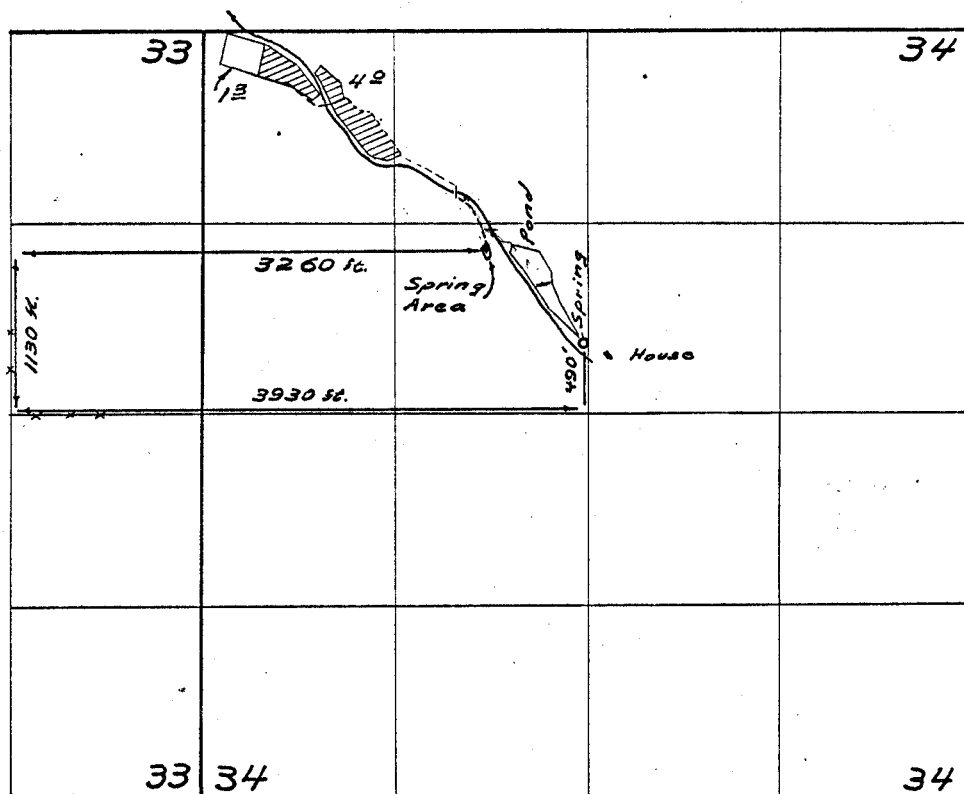

FINAL PROOF SURVEY
UNDER

40396 30207
Application No. R-40661 Permit No. R-4542
IN NAME OF

Harold A. Wright

Surveyed June 25 1966, by W. J. Ruppert