


# T. 1 S. R. 4 E. W. M.

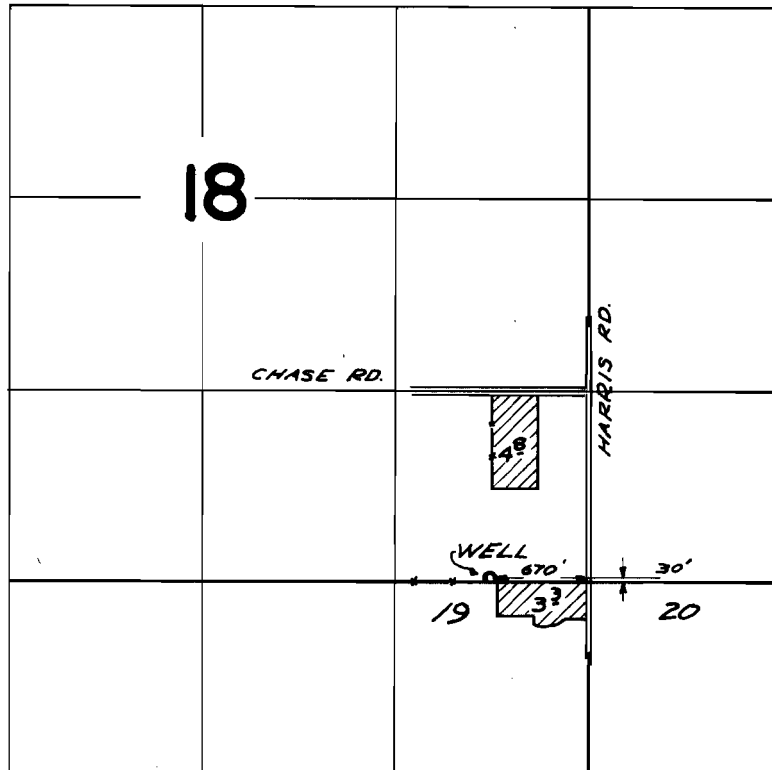

## FINAL PROOF SURVEY UNDER

Application No. G-2145 Permit No. G-1989  
IN NAME OF

POWELL VALLEY NURSERY

Surveyed Sept. 1, 1966, by V. GARNER