


T.1N.&1S.R.5E. W.M.

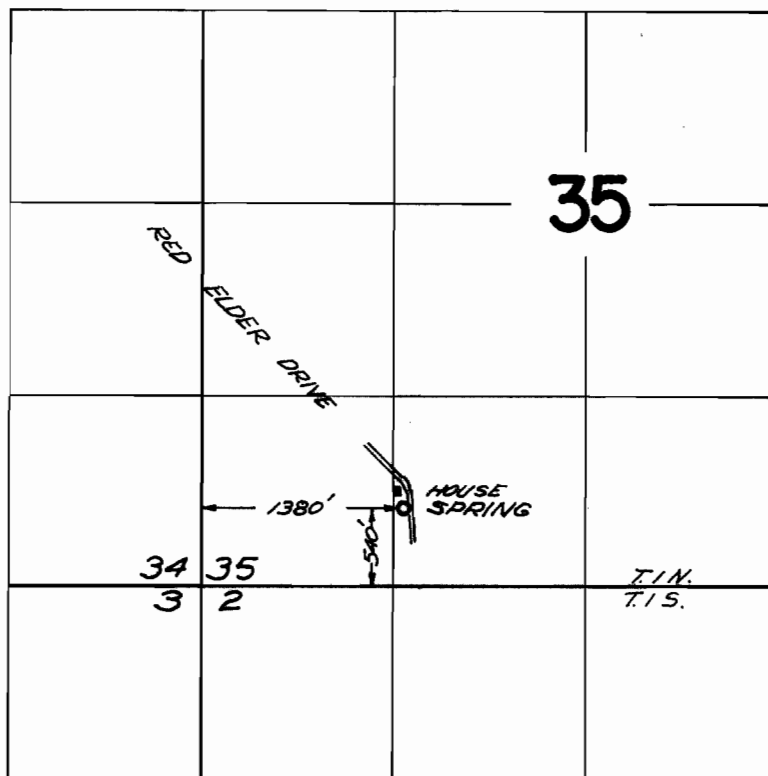

FINAL PROOF SURVEY UNDER

Application No. 38240 Permit No. 28486
IN NAME OF

RAYMOND T. and GEORGIA M. FLEMING

Surveyed Aug. 29, 1966, by V. GARNER