


T. 7 S. R. 3 & 4 W. W. M.

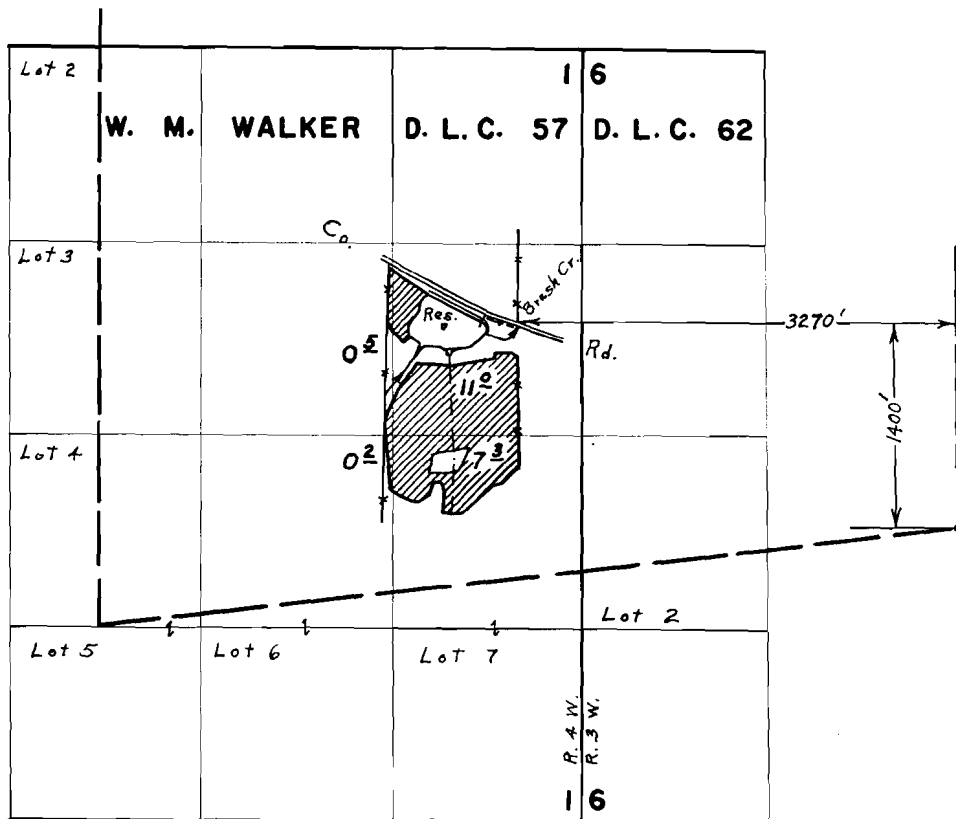

FINAL PROOF SURVEY UNDER

R-39165 R-3879
 39166 29186
 R-41783 R-4771
 Application No. 41784 Permit No. 31364

IN NAME OF
PAUL W. SHEPARD

Surveyed April 20, 1967, by L. E. Gould